

Dist	COUNTY	ROUTE	POST MILES TOTAL PROJECT	SHEET No.	TOTAL SHEETS
03	Pla	80	0.3/29.3	18B	56

REGISTERED CIVIL ENGINEER DATE 2-10-11
 9-13-10
 PLANS APPROVAL DATE

REGISTERED PROFESSIONAL ENGINEER
 JUSTIN A. UNCK
 No. C65889
 Exp. 12-31-11
 CIVIL
 STATE OF CALIFORNIA

THE STATE OF CALIFORNIA OR ITS OFFICERS OR AGENTS SHALL NOT BE RESPONSIBLE FOR THE ACCURACY OR COMPLETENESS OF SCANNED COPIES OF THIS PLAN SHEET.

LEGEND:

- REMOVE ASPHALT CONCRETE SURFACING - SEE STRUCTURE PLANS
COLD PLANE AC Pvmnt
- CONSTRUCT THIS STAGE


STAGE CONSTRUCTION NOTES:

STAGE 2A AND 2B - IN ONE 60 HOUR CLOSURE WINDOW, PLACE NEW EASTBOUND APPROACH AND DEPARTURE SLABS, REMOVE AC SURFACING FROM BRIDGE DECK, AND COLD PLANE OVERBUILT STRUCTURAL SECTION AT CONFORM TAPER. SEE DETAIL A AND CONFORM AT STRUCTURES - STAGE 2A AND 2B DETAIL THIS PAGE, AND STRUCTURE PLANS.


STAGE 3 - REPLACE MEDIAN BARRIER REMOVED IN STAGE 2B. REPLACE EASTBOUND CONCRETE BRIDGE BARRIER ON OUTSIDE SHOULDER.

STAGE 4 ~~STAGE 5~~ - PLACE POLYESTER CONCRETE OVERLAY ON EASTBOUND LANES. POLYESTER CONCRETE OVERLAY MUST BE PLACED WITHIN 14 DAYS AFTER REMOVING AC SURFACING FROM BRIDGE DECK.


STAGE 5 ~~STAGE 4~~ - COLD PLANE HMA PAVEMENT AND PLACE RHMA (OPEN GRADED) ON EASTBOUND LANES, ONCE STAGES 1-4 HAVE BEEN COMPLETED AT ALL THREE BRIDGES.

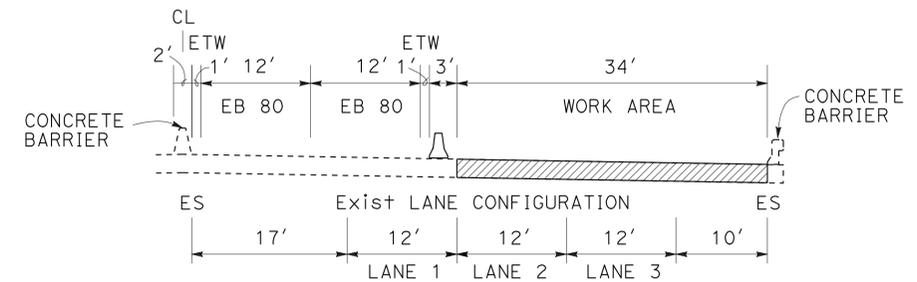


STAGE 2A

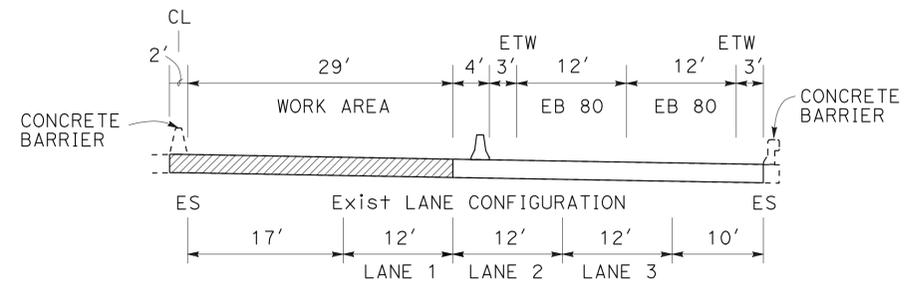


STAGE 2B

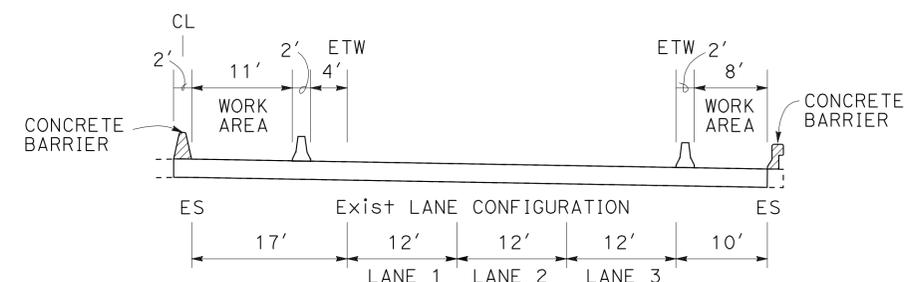

STAGE 3

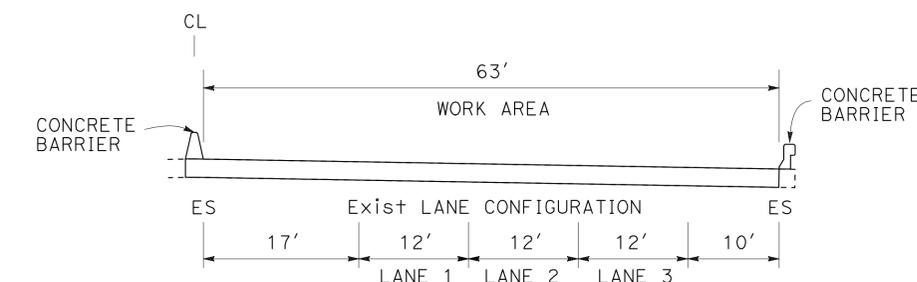


STAGE 4
STAGE 5

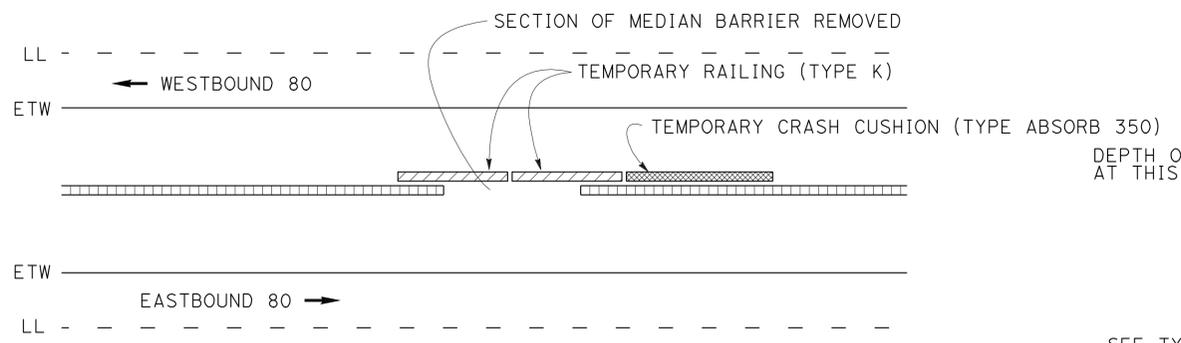

DETAIL A

PROTECT TRAFFIC FROM OPENING IN BARRIER. TEMPORARY RAILING (TYPE K) SHALL REMAIN IN PLACE UNTIL NEW CONCRETE BARRIER IS CURED OR AS DIRECTED BY THE ENGINEER. STAGE 3 TEMPORARY RAILING (TYPE K) WILL PROTECT EASTBOUND TRAFFIC.

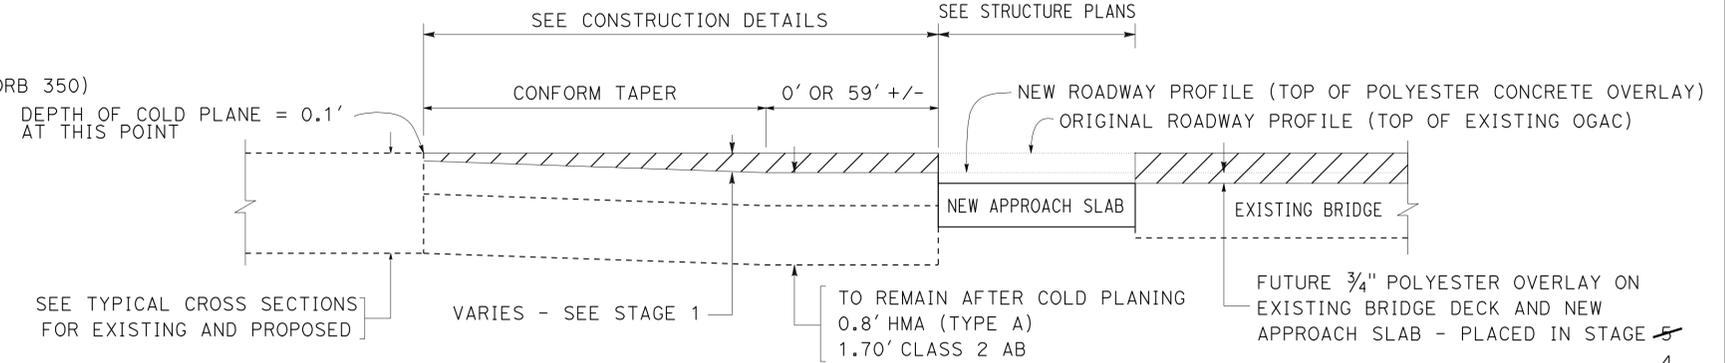

DEPTH OF COLD PLANE = 0.1' AT THIS POINT

SEE TYPICAL CROSS SECTIONS FOR EXISTING AND PROPOSED

VARIES - SEE STAGE 1

TO REMAIN AFTER COLD PLANING
0.8' HMA (TYPE A)
1.70' CLASS 2 AB

FUTURE 3/4" POLYESTER OVERLAY ON EXISTING BRIDGE DECK AND NEW APPROACH SLAB - PLACED IN STAGE 5

CONFORM AT STRUCTURES - STAGE 2A AND 2B



**REVISED PER ADDENDUM No. 3
DATED MARCH 8, 2011**

**BOWMAN UC BRIDGE No. 19-0042
BOWMAN OH (SOUTH) BRIDGE No. 19-0023
BOWMAN OH (NORTH) BRIDGE No. 19-0024**



ADDED PER ADDENDUM No. 2 DATED FEBRUARY 25, 2011

STAGE CONSTRUCTION

NO SCALE

SC-7