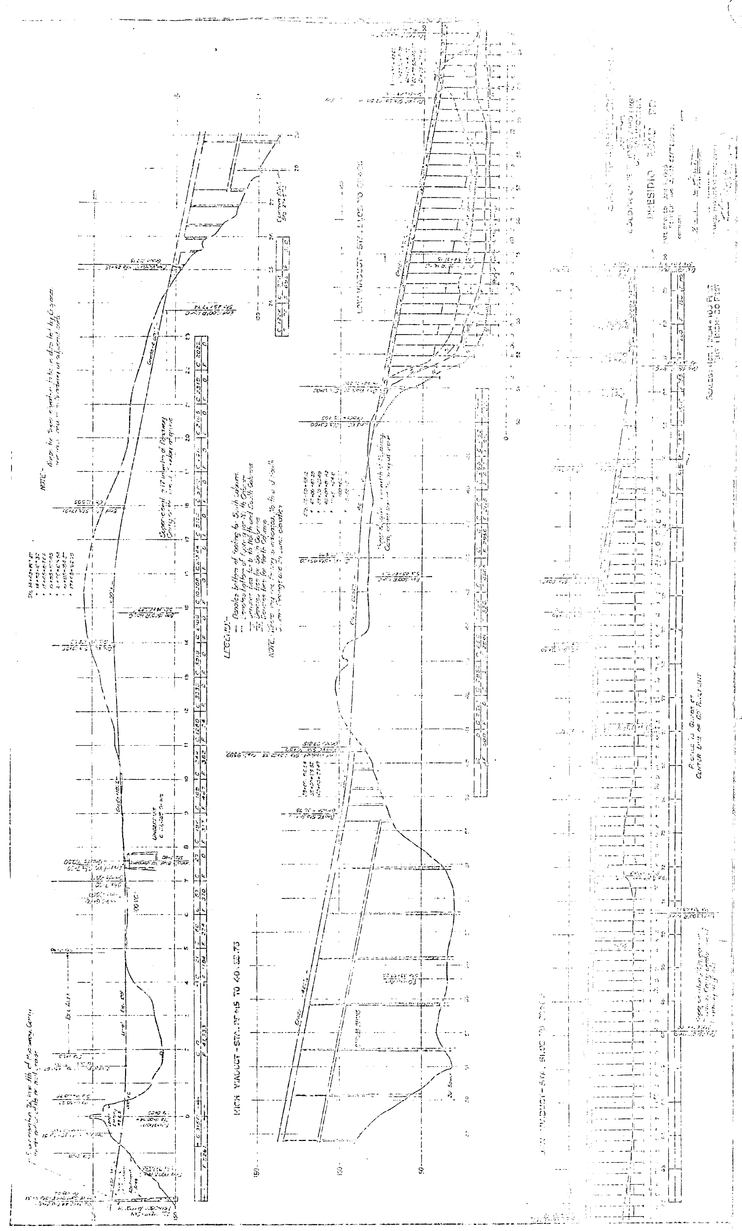

 

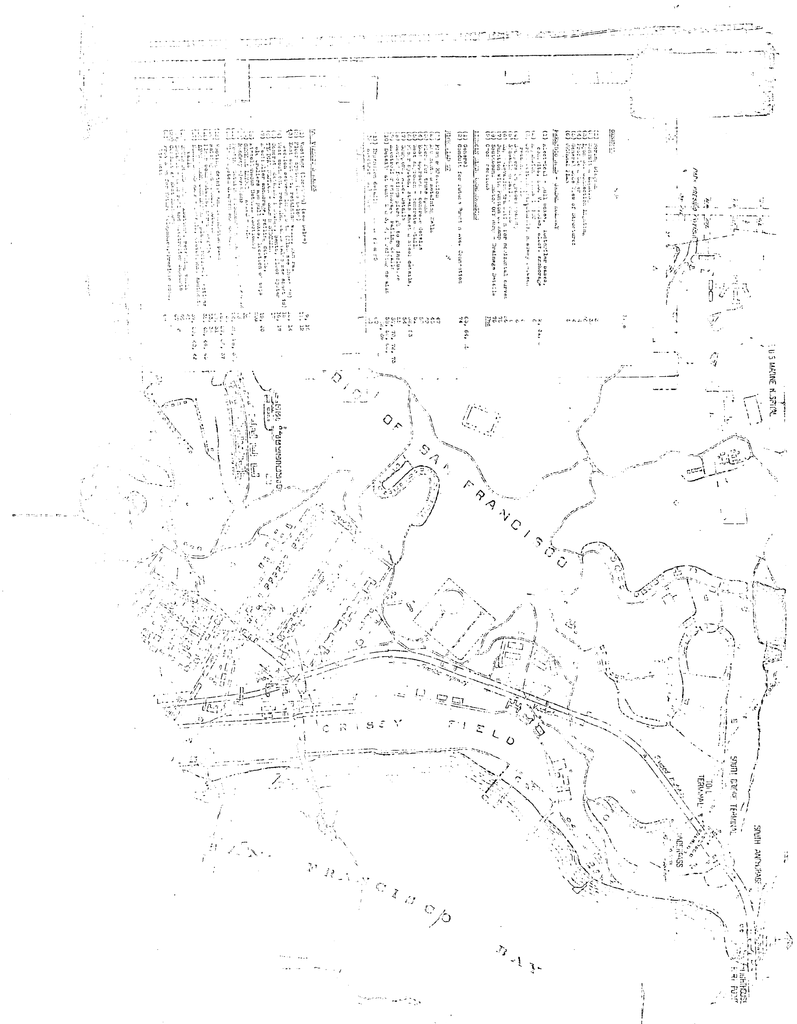
CITY OF SAN FRANCISCO
CRISSY FIELD
SAN FRANCISCO BAY
U.S. MARINE HOSPITAL
SOUTH DOCK TERMINAL
SOUTH ANCHORAGE

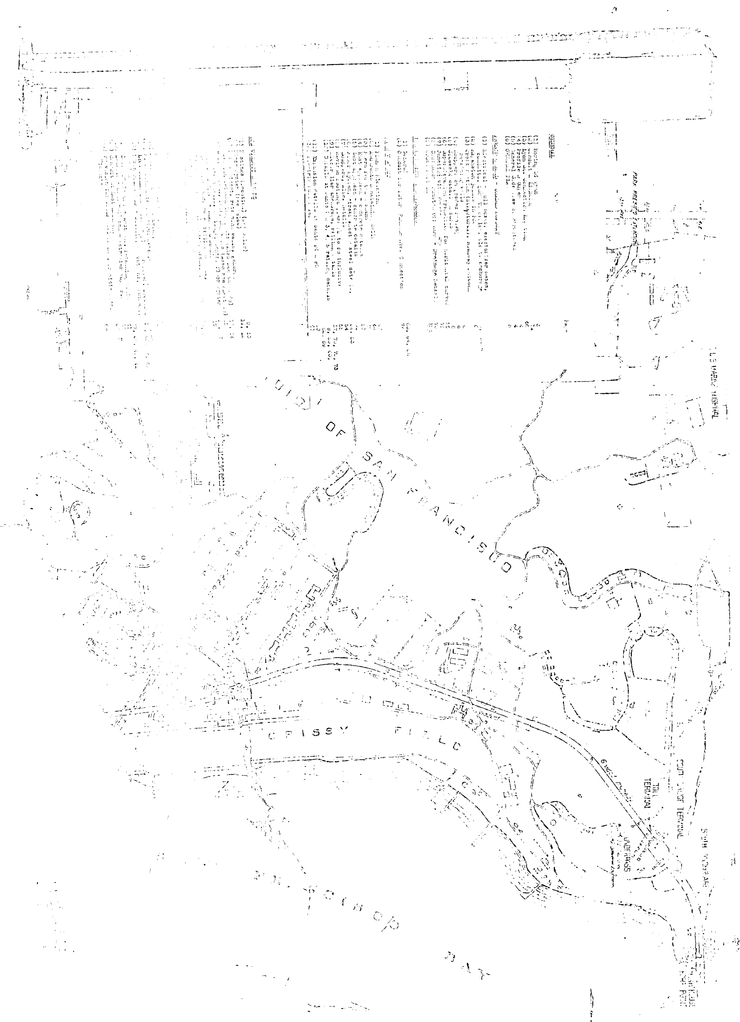
CITY OF SAN FRANCISCO
CRISSY FIELD
SAN FRANCISCO BAY

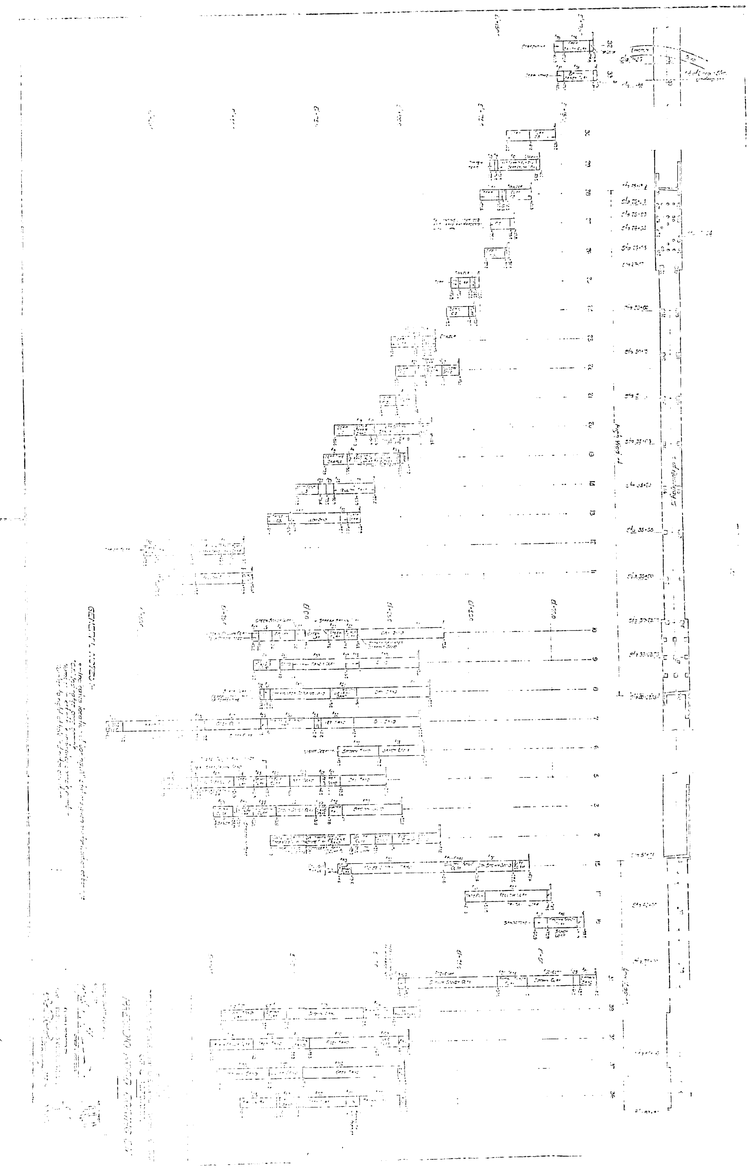

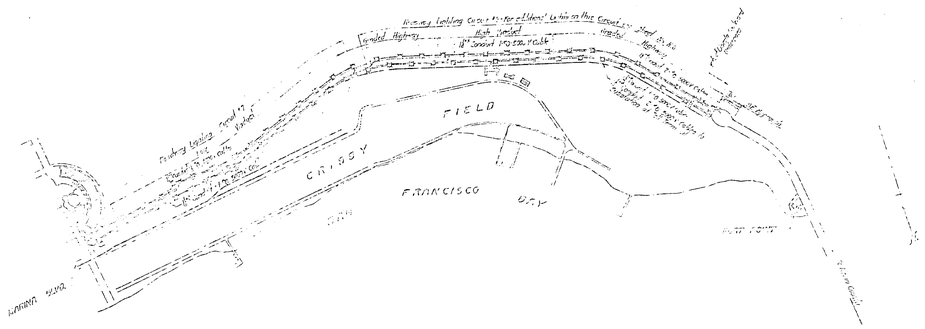
FIELD
CRISSY
FRANCISCO
BAY

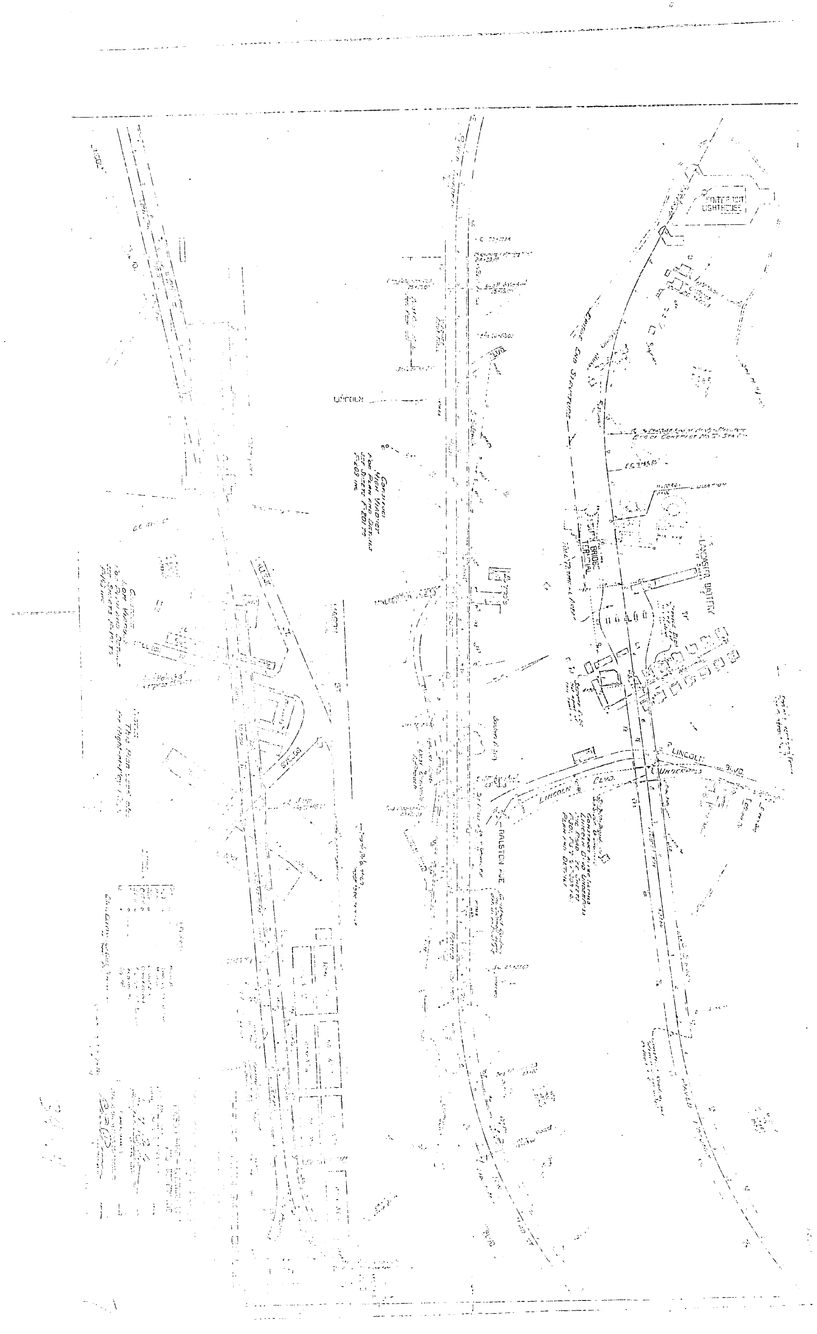

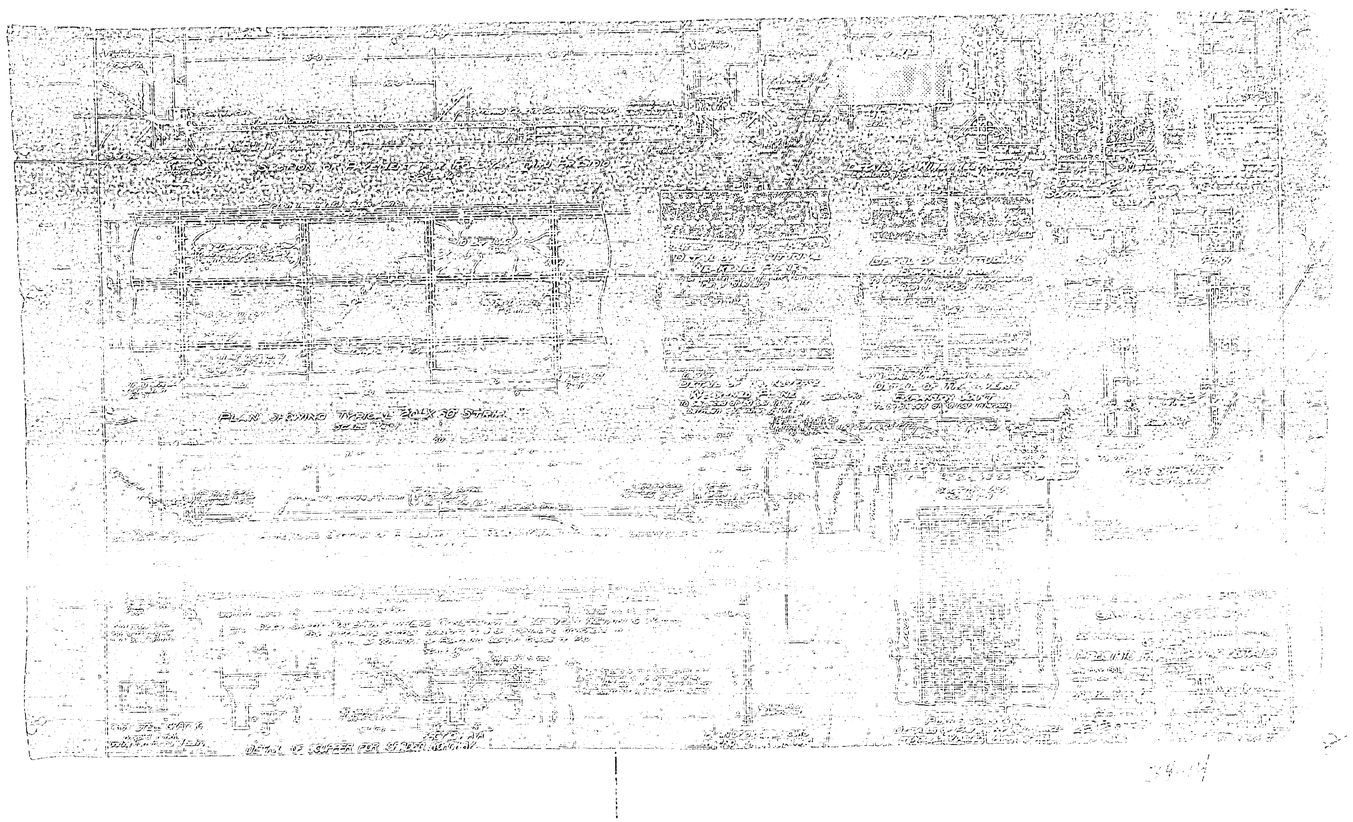

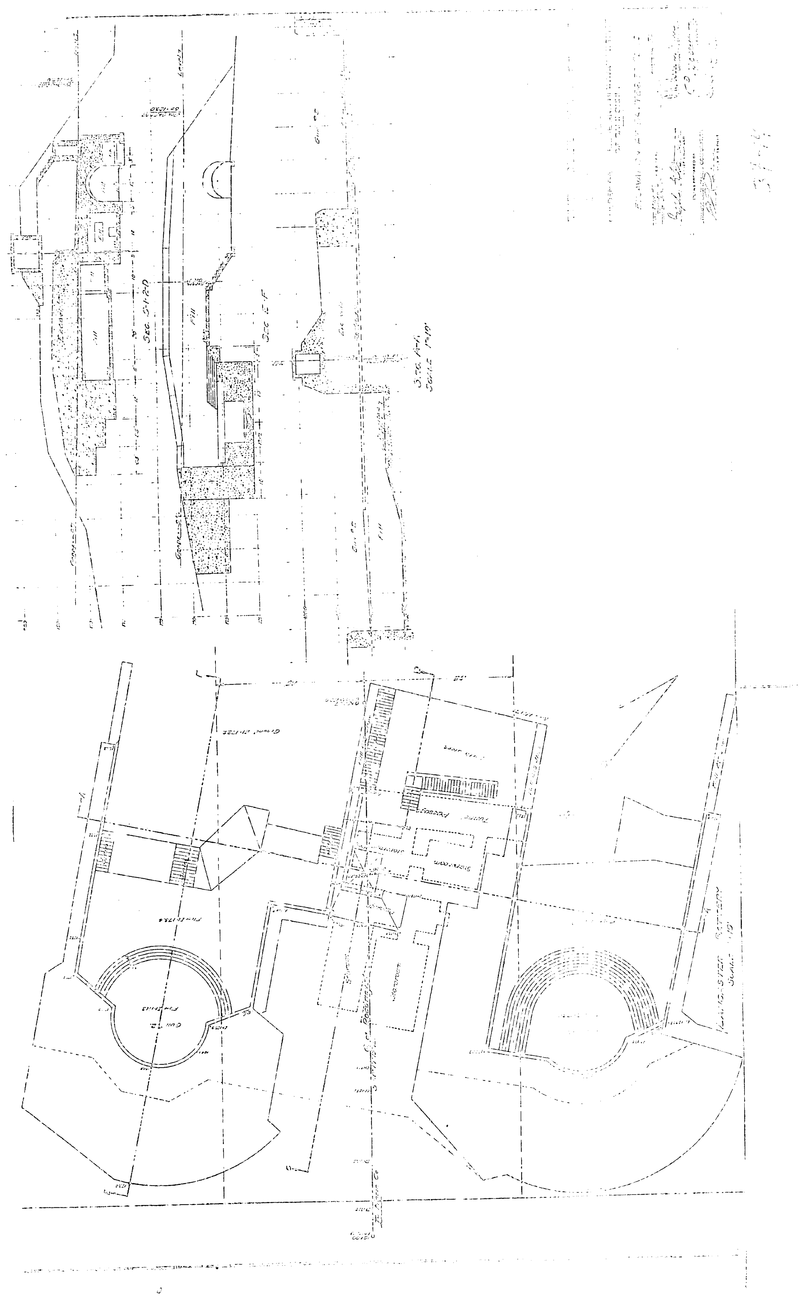

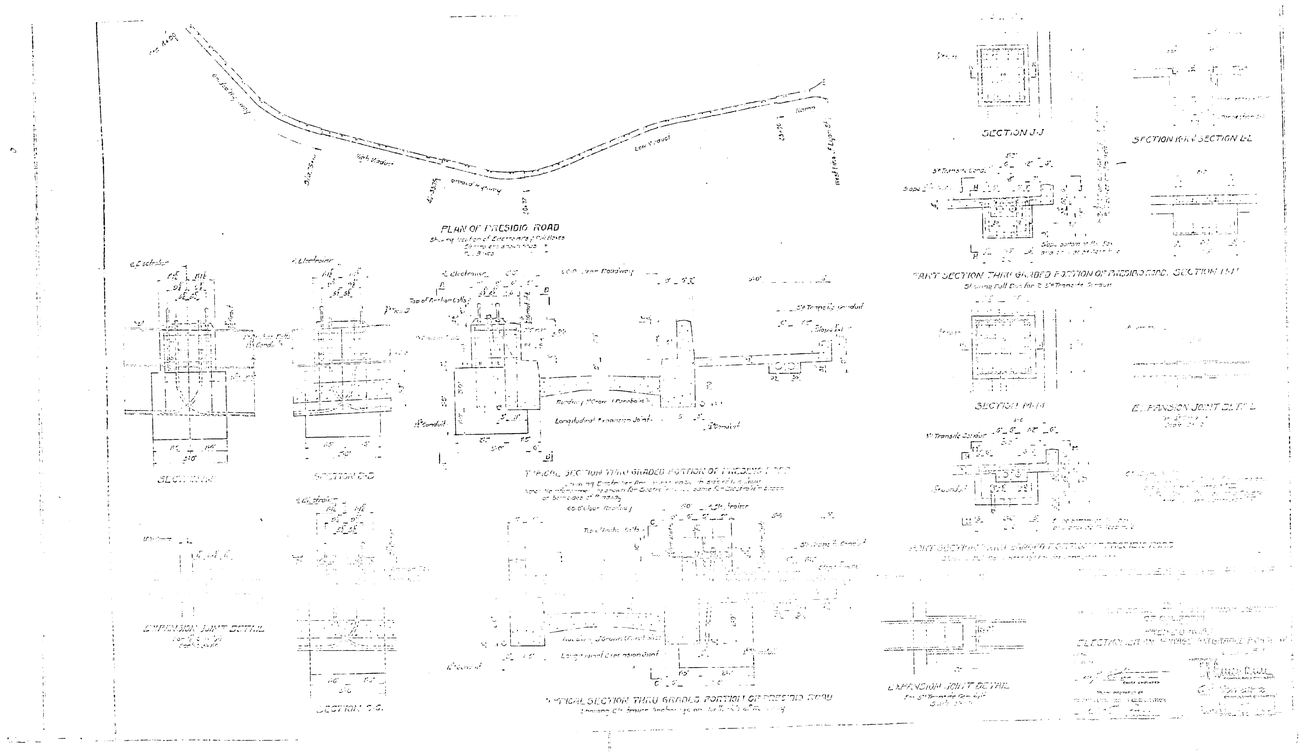
PLAN OF PRESIDIO ROAD
SECTION J-J
SECTION K-K SECTION L-L
SECTION M-M
EXPANSION JOINT DETAIL
SECTION C-C
SECTION D-D
SECTION G-G
EXPANSION JOINT DETAIL

34-14

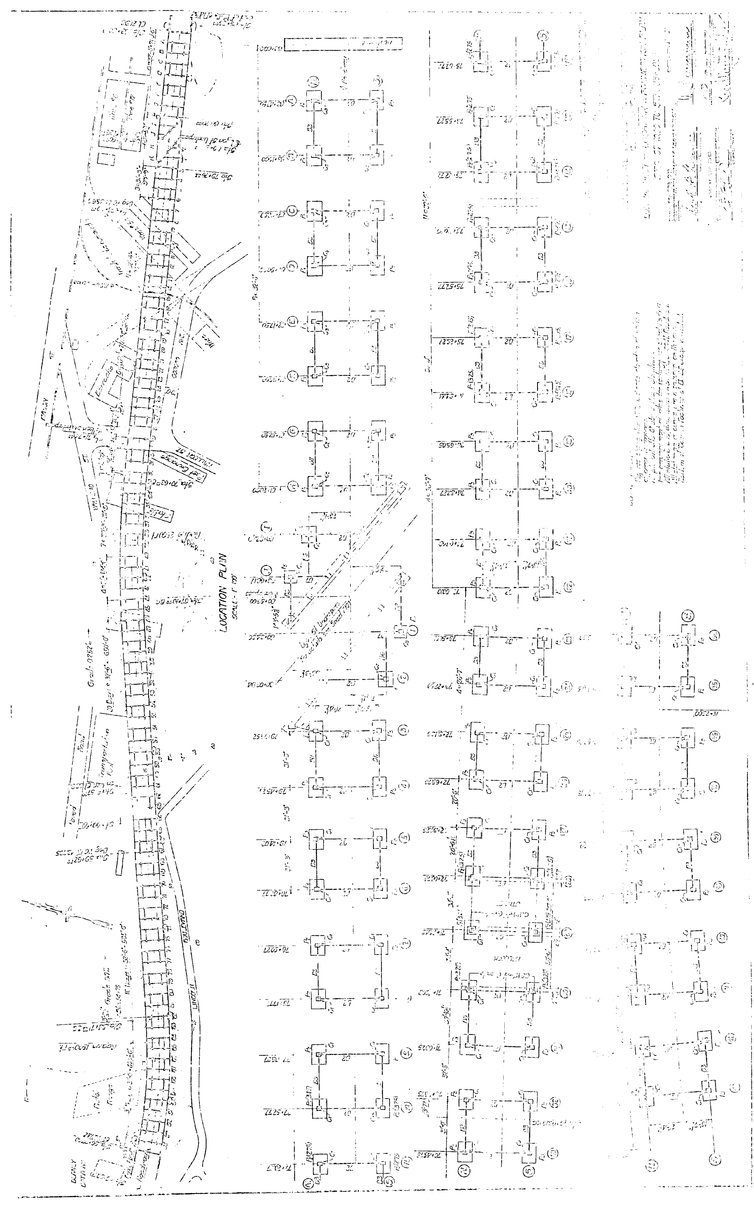
LOCATION PLAN

 

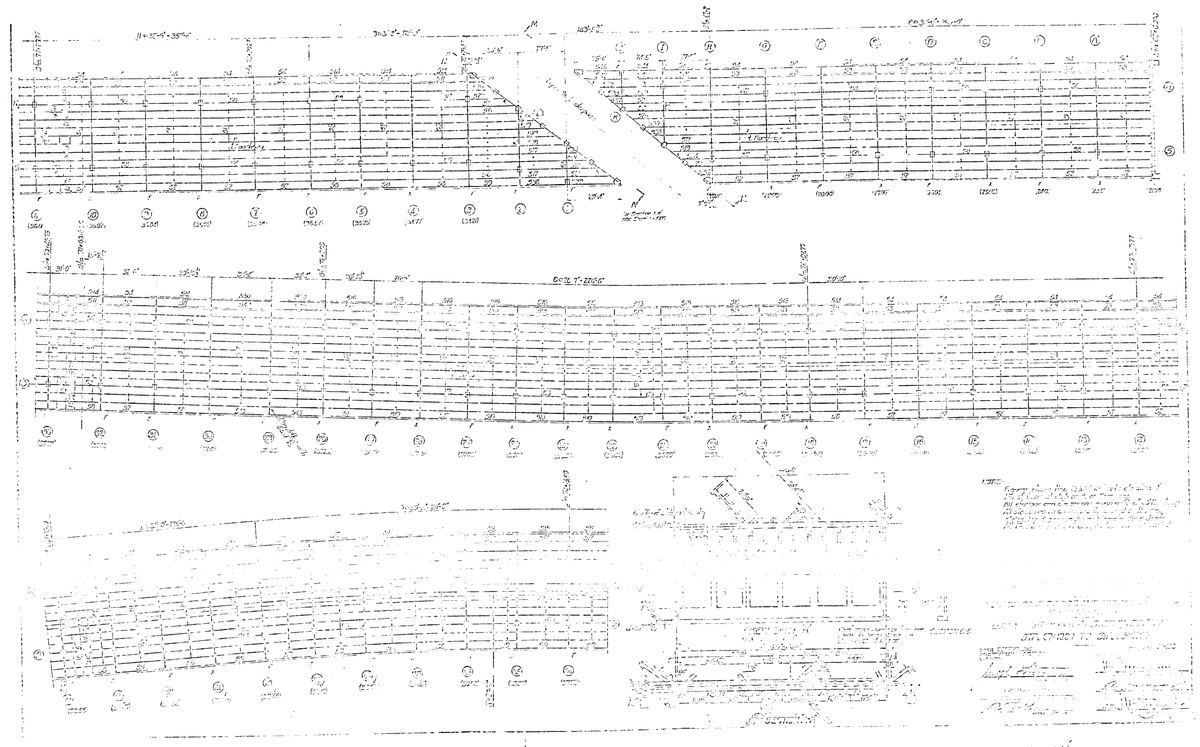

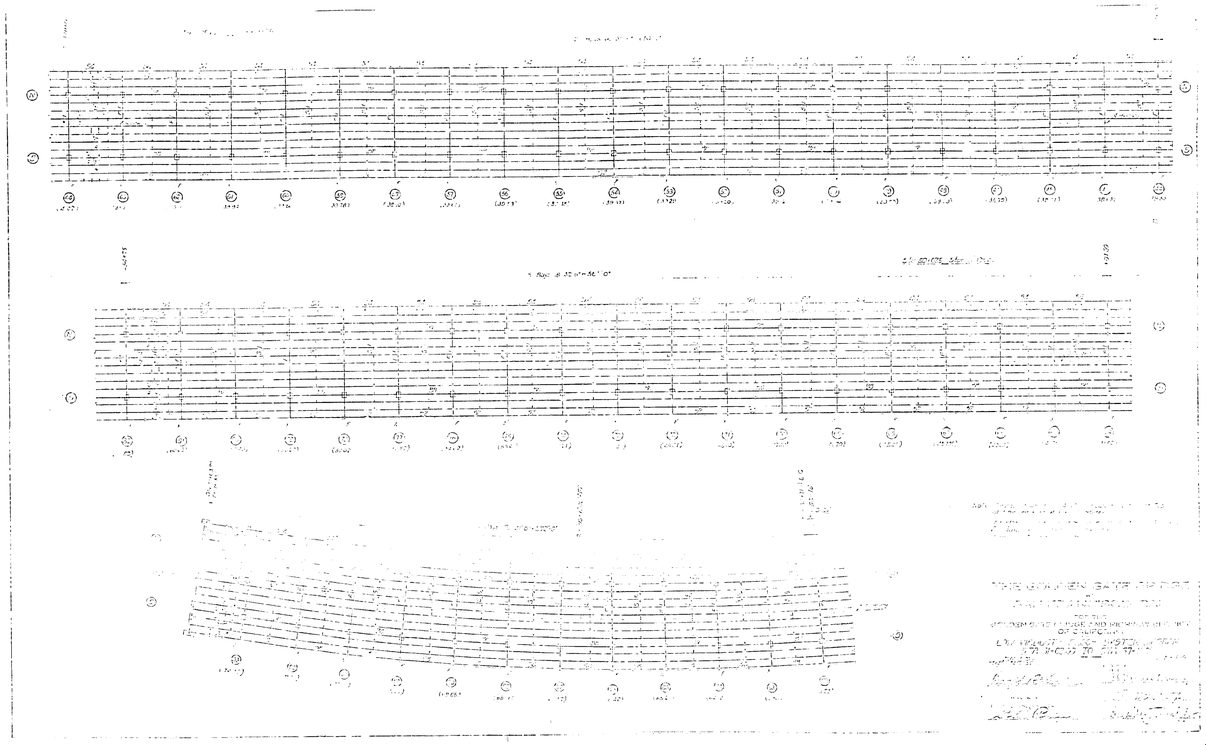

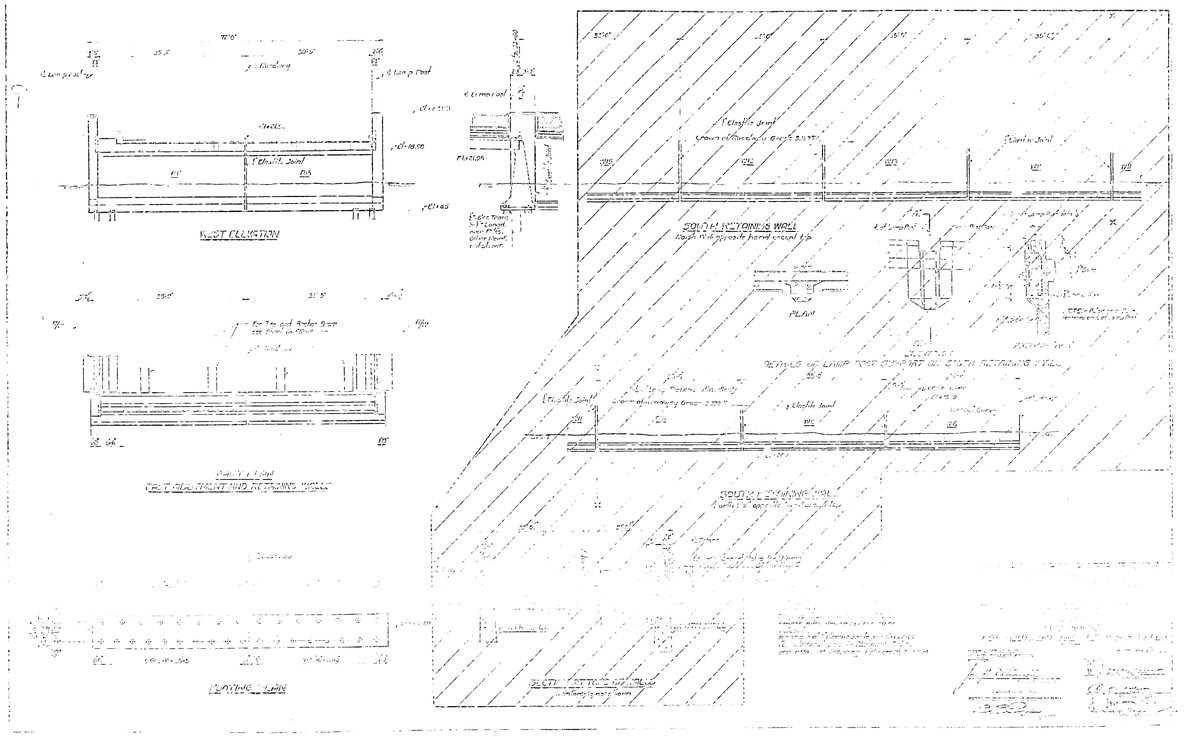
WEST ELEVATION
SOUTH RETAINING WALL
PLAN
EAST ABUTMENT AND RETAINING WALLS
SOUTH RETAINING WALL
PLAN

 

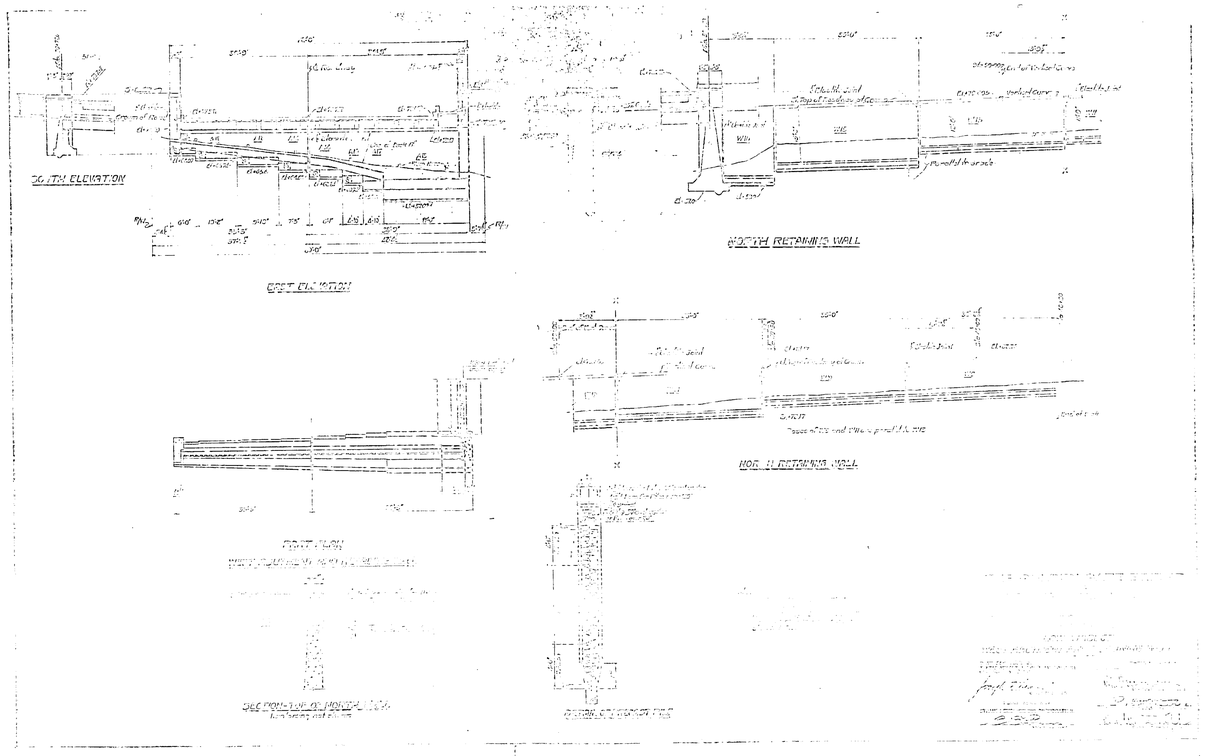
SOUTH ELEVATION
EAST ELEVATION
NORTH RETAINING WALL
HOR. RETAINING WALL

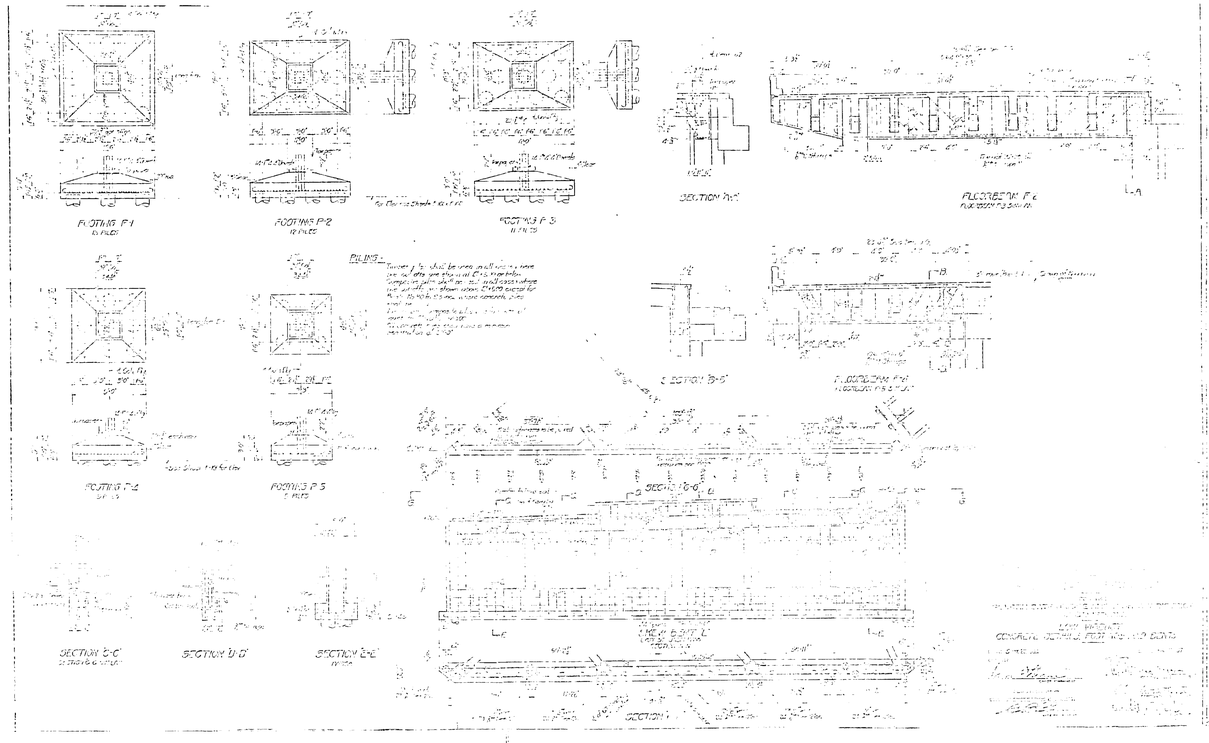
FOOTING P-1
FOOTING P-2
FOOTING P-3
SECTION "A-A"
FLOORBEAM F-2
PILING
SECTION "B-B"
FLOORBEAM F-3
FOOTING P-4
FOOTING P-5
SECTION "C-C"
SECTION "D-D"
SECTION "E-E"
SECTION "G-G"
SECTION "H-H"

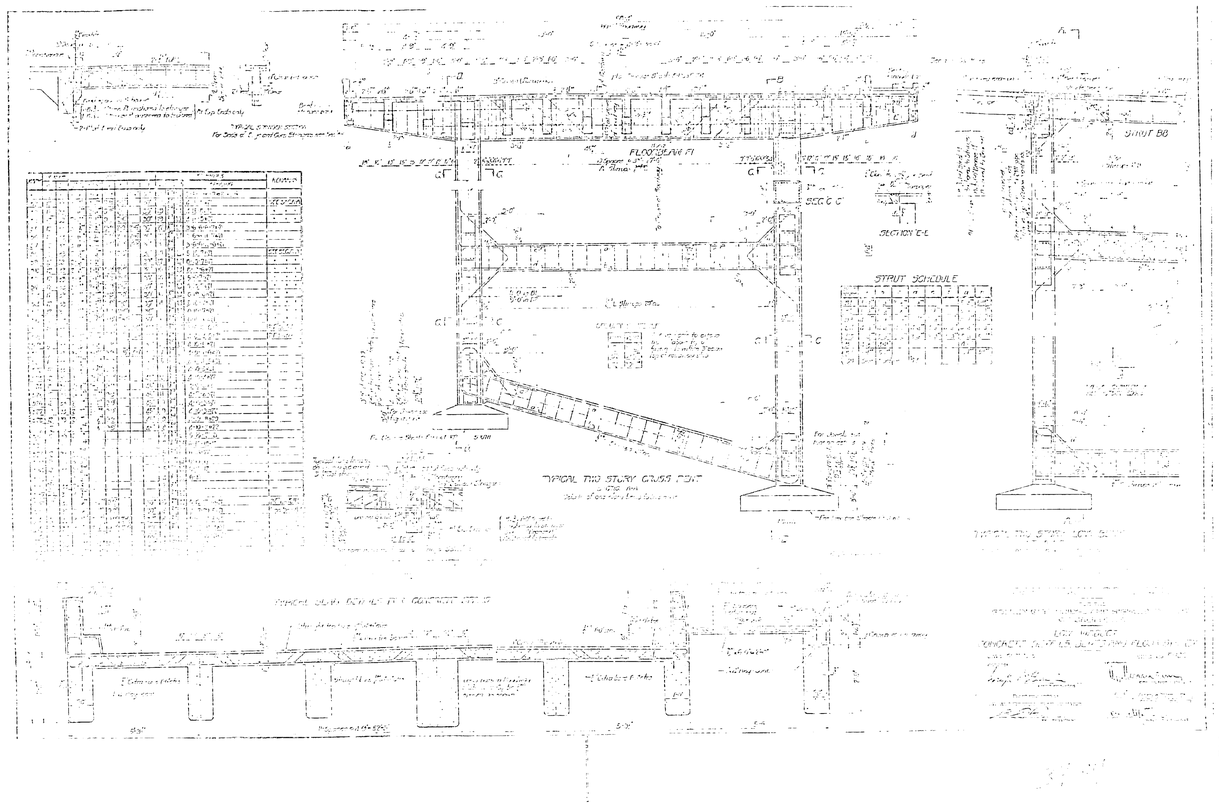
SECTION C-C
STRUT SCHEDULE
TYPICAL TWO STORY CROSS FRAME
STRUT BB

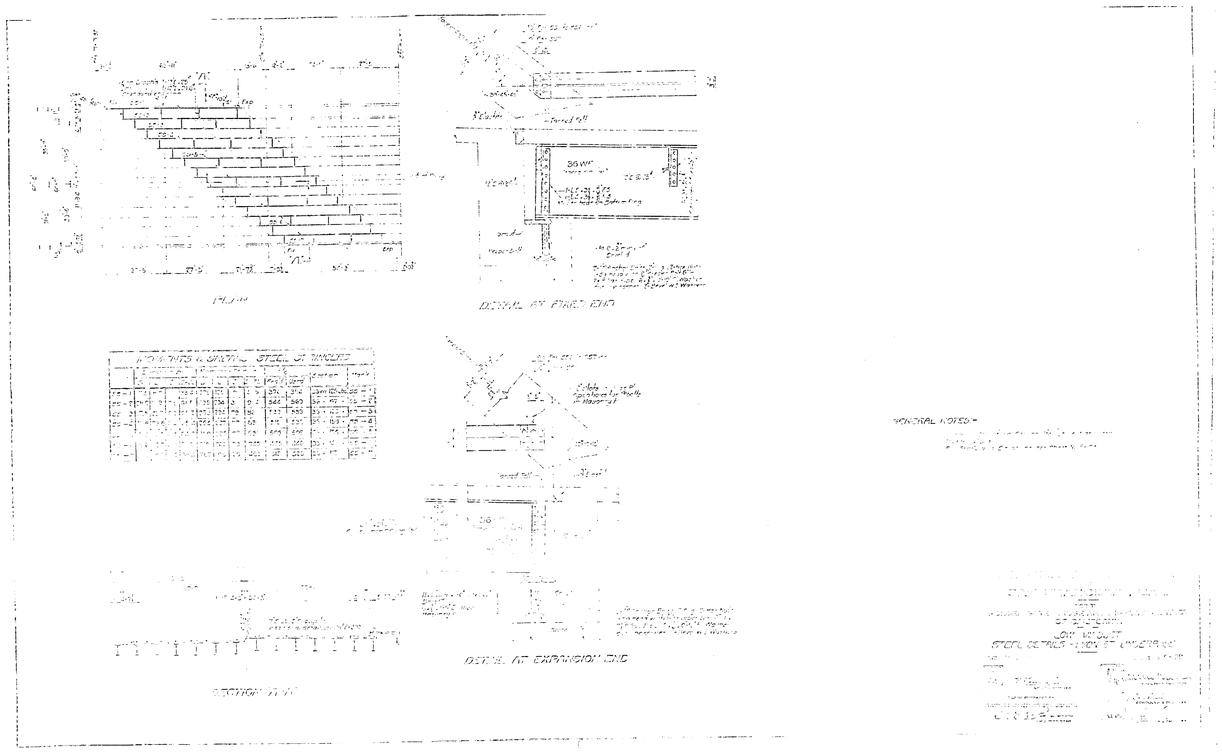
PLAN
DETAIL AT FIXED END
DETAIL AT EXPANSION END
SECTION A-A
GENERAL NOTES

 

 

 

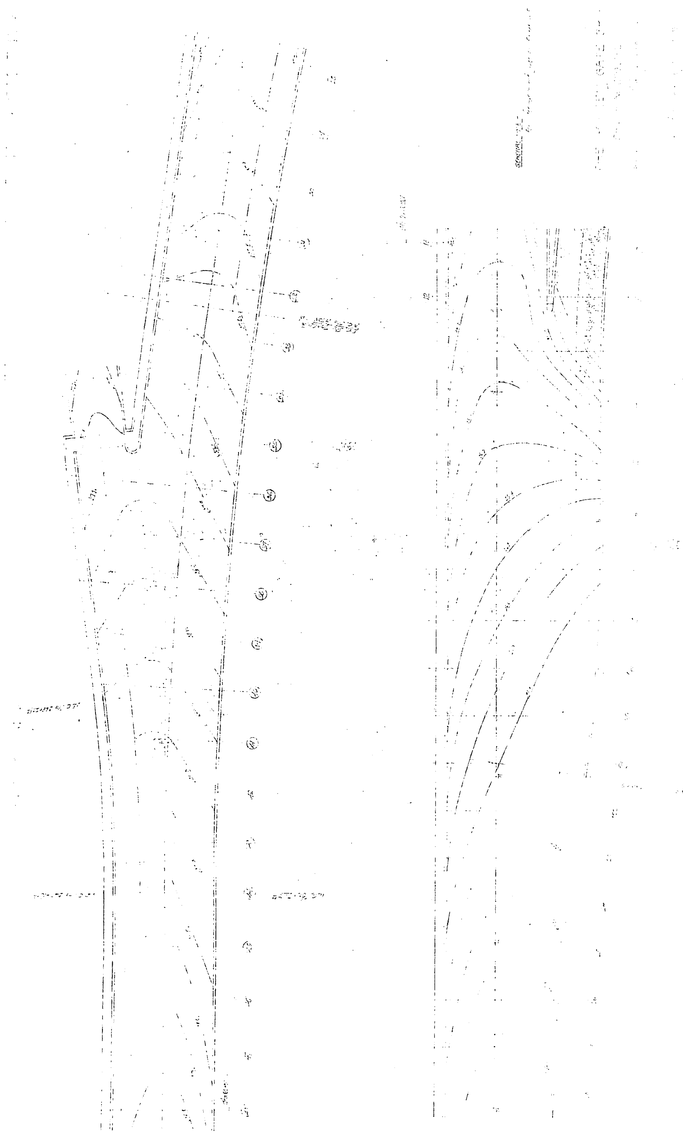

34-14

27

AS BUILT PLANS
Contract No. [illegible]
Date Completed
Document No. [illegible]

24X

I HEREBY CERTIFY THAT THIS IS A TRUE AND ACCURATE COPY OF THE ABOVE DOCUMENT TAKEN UNDER MY DIRECTION AND CONTROL ON THIS DATE IN SACRAMENTO, CALIFORNIA PURSUANT TO AUTHORIZATION BY THE DIRECTOR OF TRANSPORTATION.

DATE [illegible] | FROM [illegible] | TITLE Supervisor of Microfilm

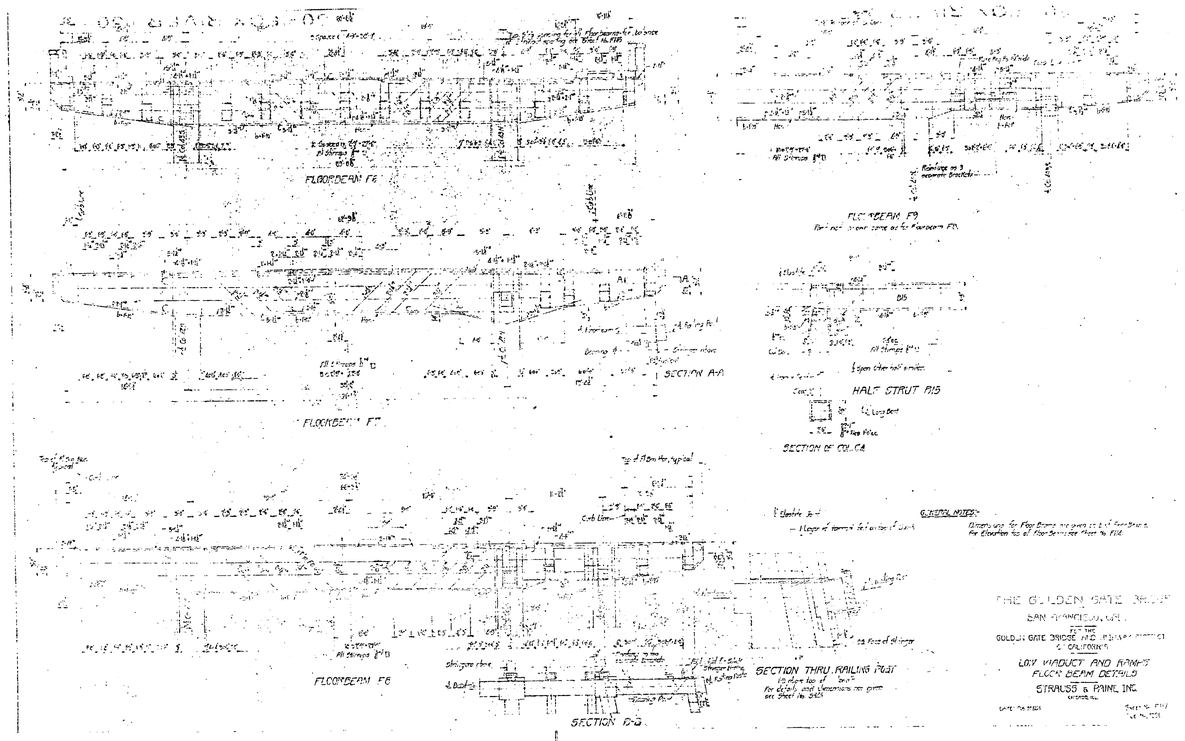

34-14

28

AS BUILT PLANS
Contract No. [illegible]
Date Completed
Document No. [illegible]

24X

I HEREBY CERTIFY THAT THIS IS A TRUE AND ACCURATE COPY OF THE ABOVE DOCUMENT TAKEN UNDER MY DIRECTION AND CONTROL ON THIS DATE IN SACRAMENTO, CALIF. OR IIA PURSUANT TO AUTHORIZATION BY THE DIRECTOR OF TRANSPORTATION.

DATE	SIGNATURE	TITLE
[illegible]	[illegible]	[illegible]

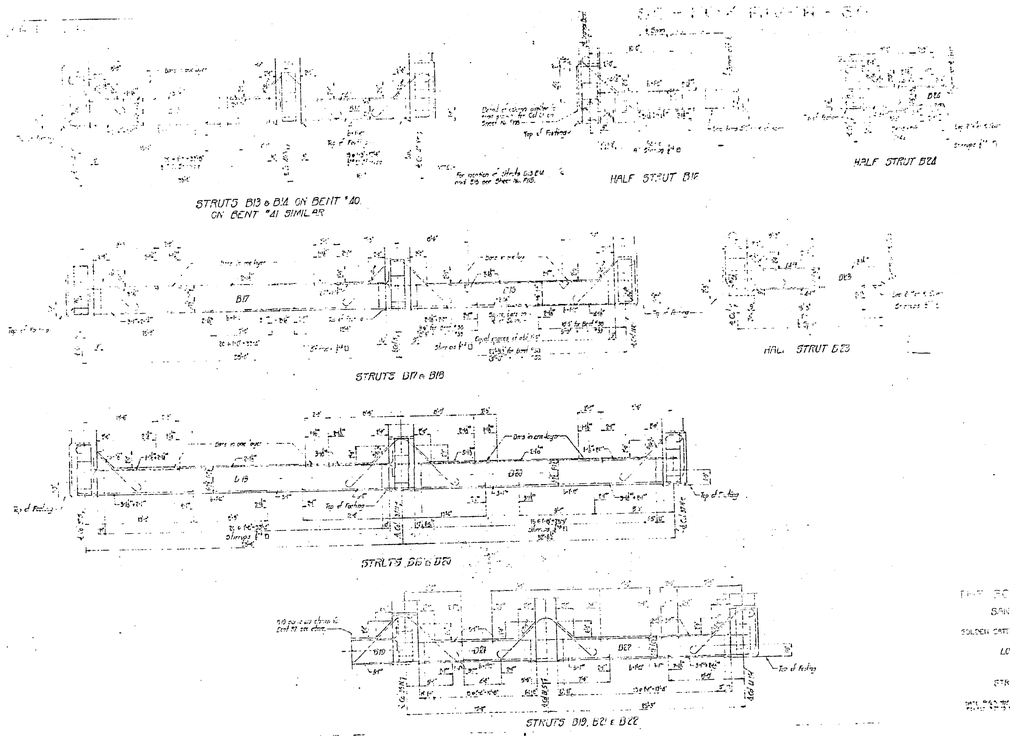

THE GOLDEN GATE BRIDGE
SAN FRANCISCO, CA
FOR THE
GOLDEN GATE BRIDGE AND HIGHWAY DISTRICT
OF CALIFORNIA
LOW VAQUET & RAMPS
DETAILS
STRAUSS & PAINE, INC.
DESIGNED

34-14

29

AS BUILT PLANS
Contract No. [illegible]
Date Completed
Document No. [illegible]

24X

I HEREBY CERTIFY THAT THIS IS A TRUE AND ACCURATE COPY OF THE ABOVE DOCUMENT TAKEN UNDER MY DIRECTION AND CONTROL ON THIS DATE IN SACRAMENTO, CALIFORNIA PURSUANT TO AUTHORIZATION BY THE DIRECTOR OF TRANSPORTATION.

DATE	SIGNATURE	TITLE
[illegible]	[illegible]	[illegible]

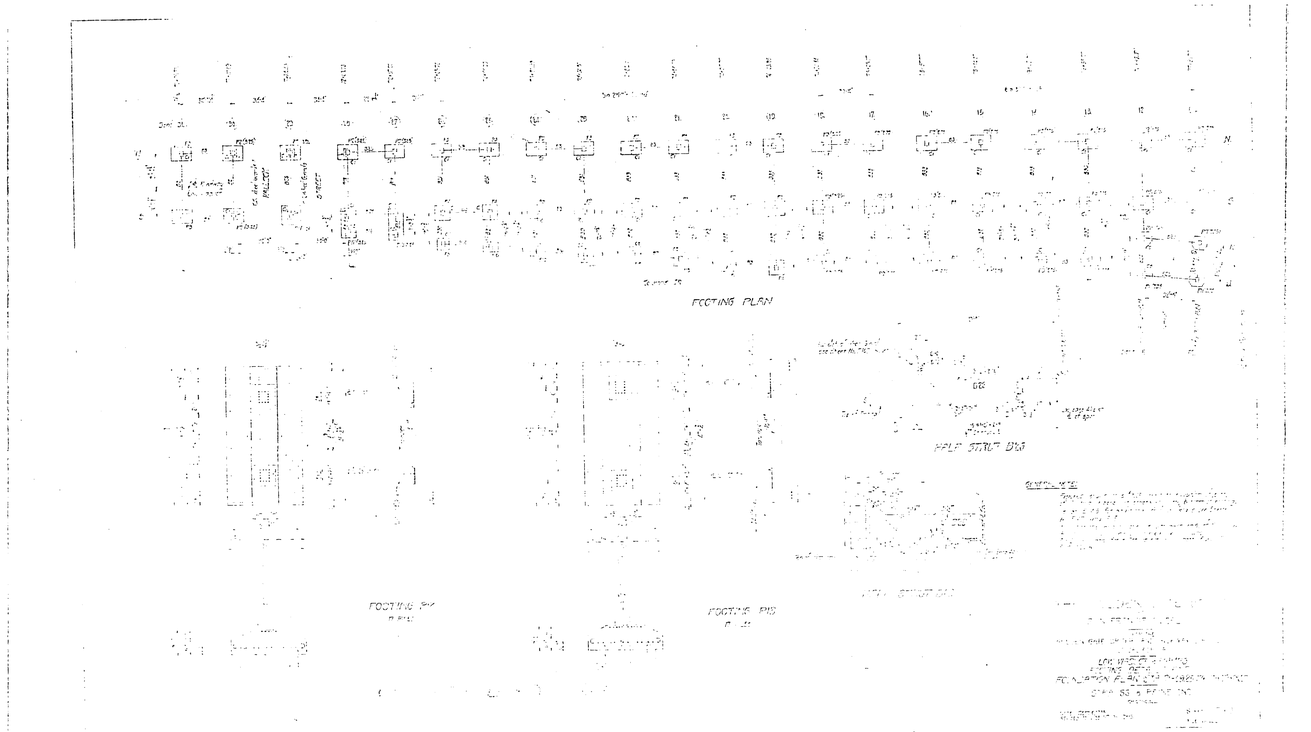

30

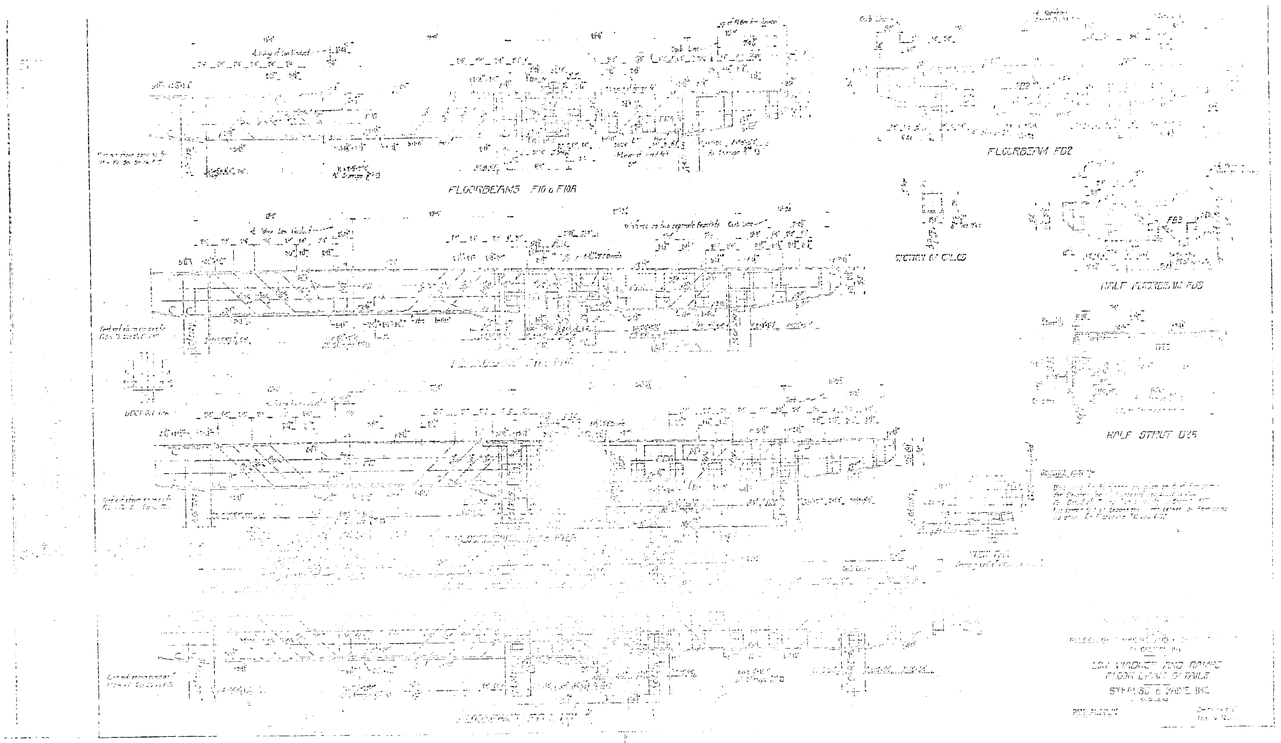
FLOORBEAMS F10 & F10A
FLOORBEAM FB2
HALF FLOORBEAM FB3
HALF STRUT D25

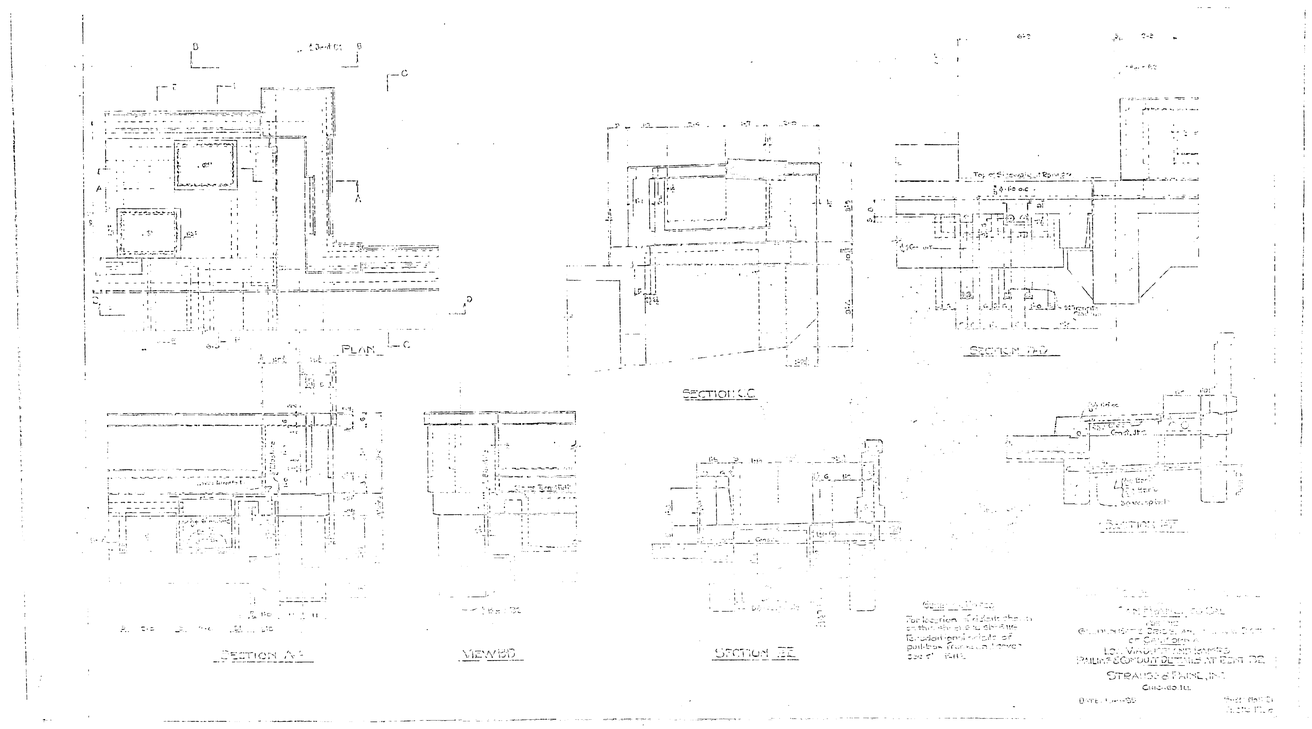

37-4

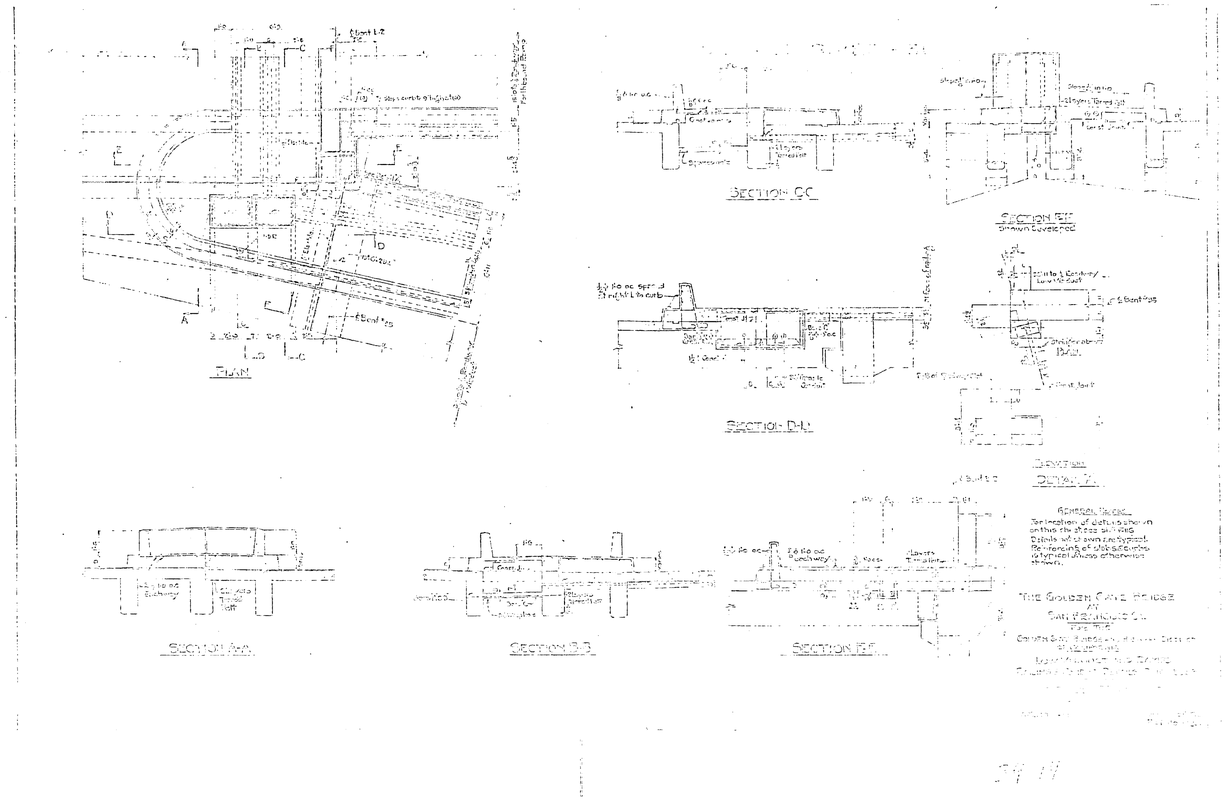
PLAN
SECTION C-C
SECTION E-E
Shown Developed
SECTION D-D
SECTION A-A
SECTION B-B
SECTION F-F
THE GOLDEN GATE BRIDGE
AT
SAN FRANCISCO CAL.

34

34-14

AS BUILT PLANS
Contract No. UNKNOWN
Date Completed
Document No. 4000 7595

24X

I HEREBY CERTIFY THAT THIS IS A TRUE AND ACCURATE COPY OF THE ABOVE DOCUMENT TAKEN UNDER MY DIRECTION AND CONTROL ON THIS DATE IN SACRAMENTO, CALIFORNIA PURSUANT TO AUTHORIZATION BY THE DIRECTOR OF TRANSPORTATION.

DATE | SIGNATURE | TITLE

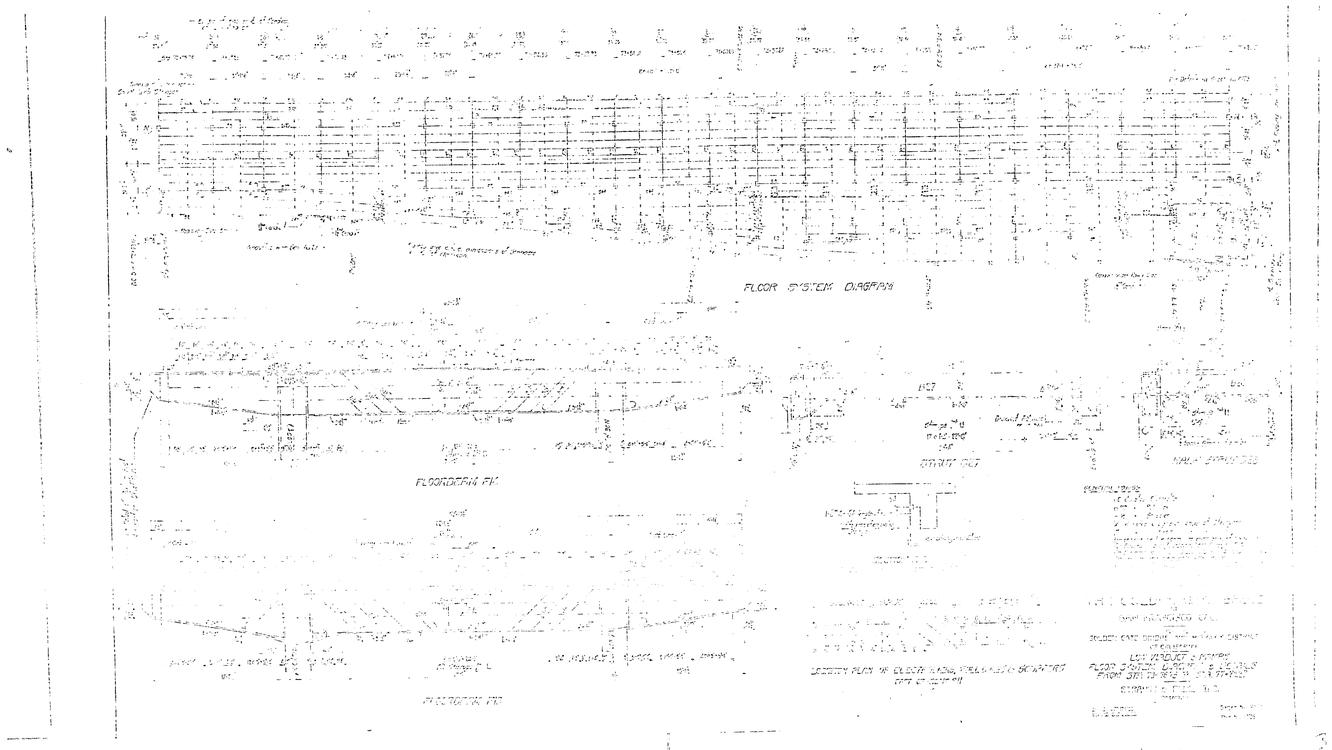

39-14

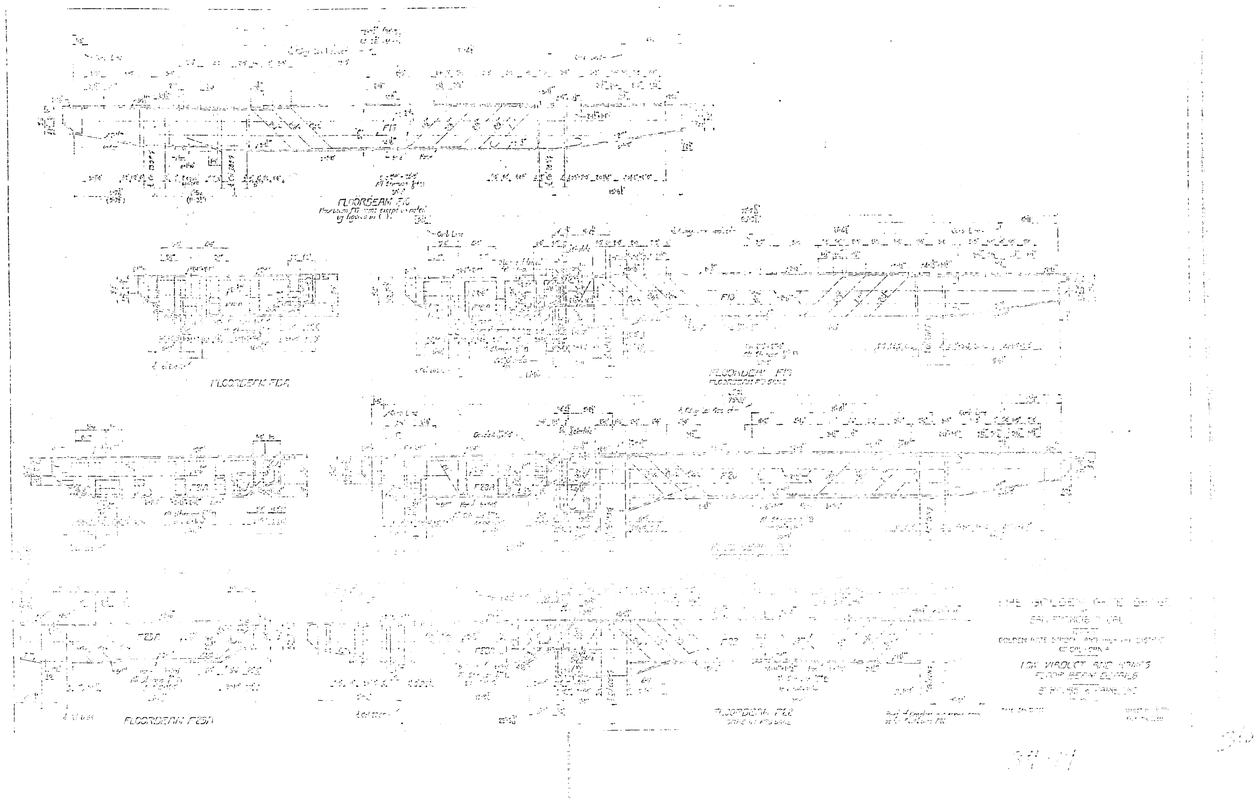

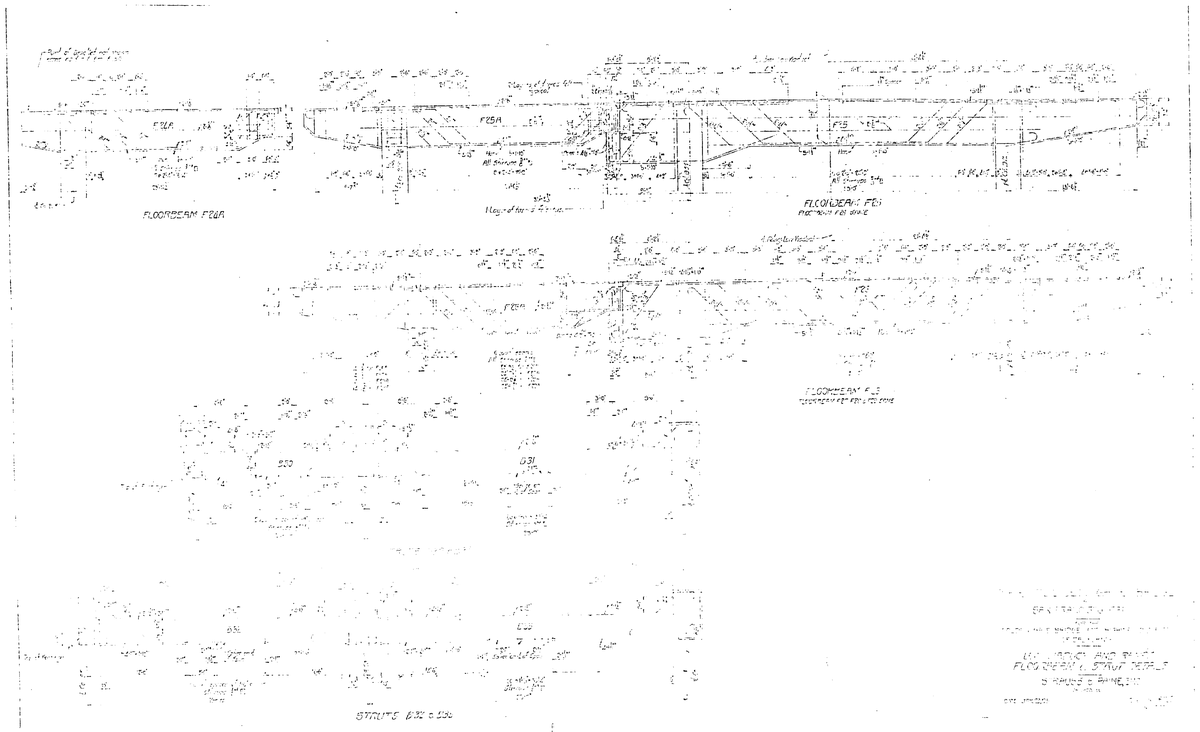
FLOORBEAM F26A
FLOORBEAM F25
FLOORBEAM F23
STRUTS B32 & B36

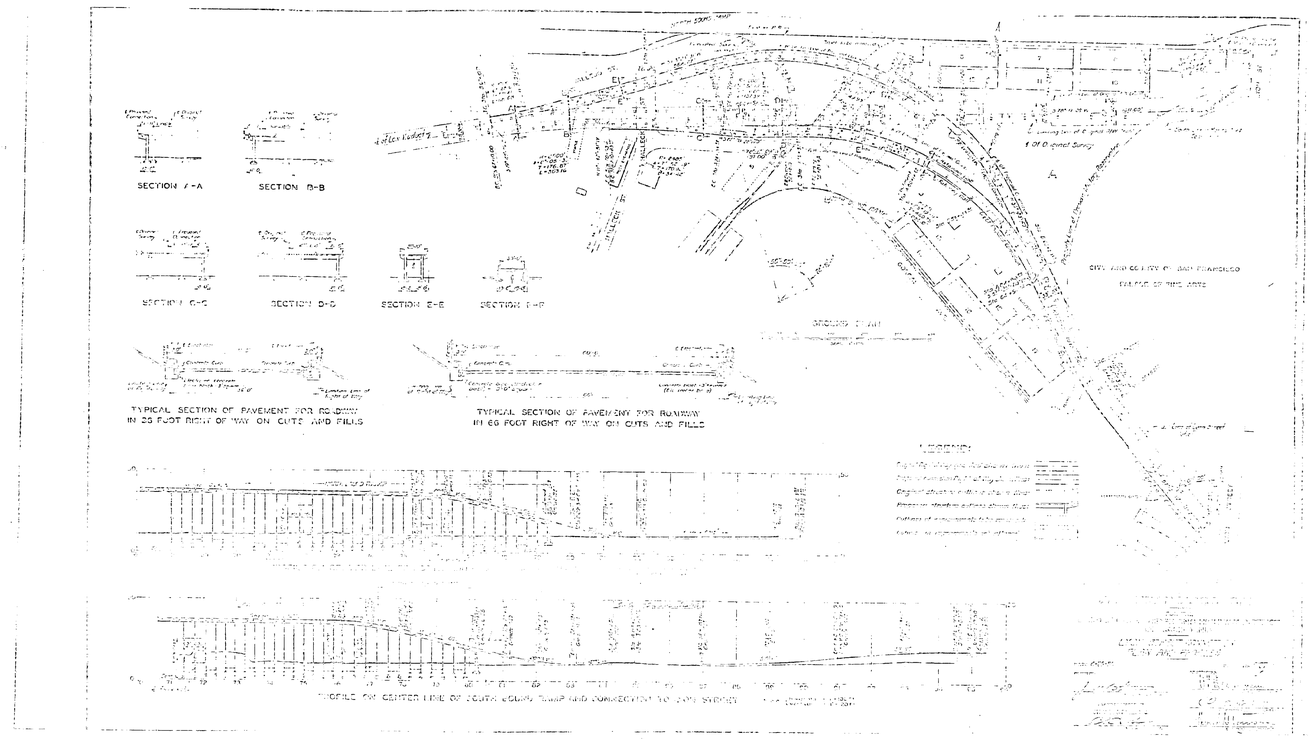
SECTION A-A
SECTION B-B
SECTION C-C
SECTION D-D
SECTION E-E
SECTION F-F
TYPICAL SECTION OF PAVEMENT FOR ROADWAY IN 25 FOOT RIGHT OF WAY ON CUTS AND FILLS
TYPICAL SECTION OF PAVEMENT FOR ROADWAY IN 60 FOOT RIGHT OF WAY ON CUTS AND FILLS
LEGEND

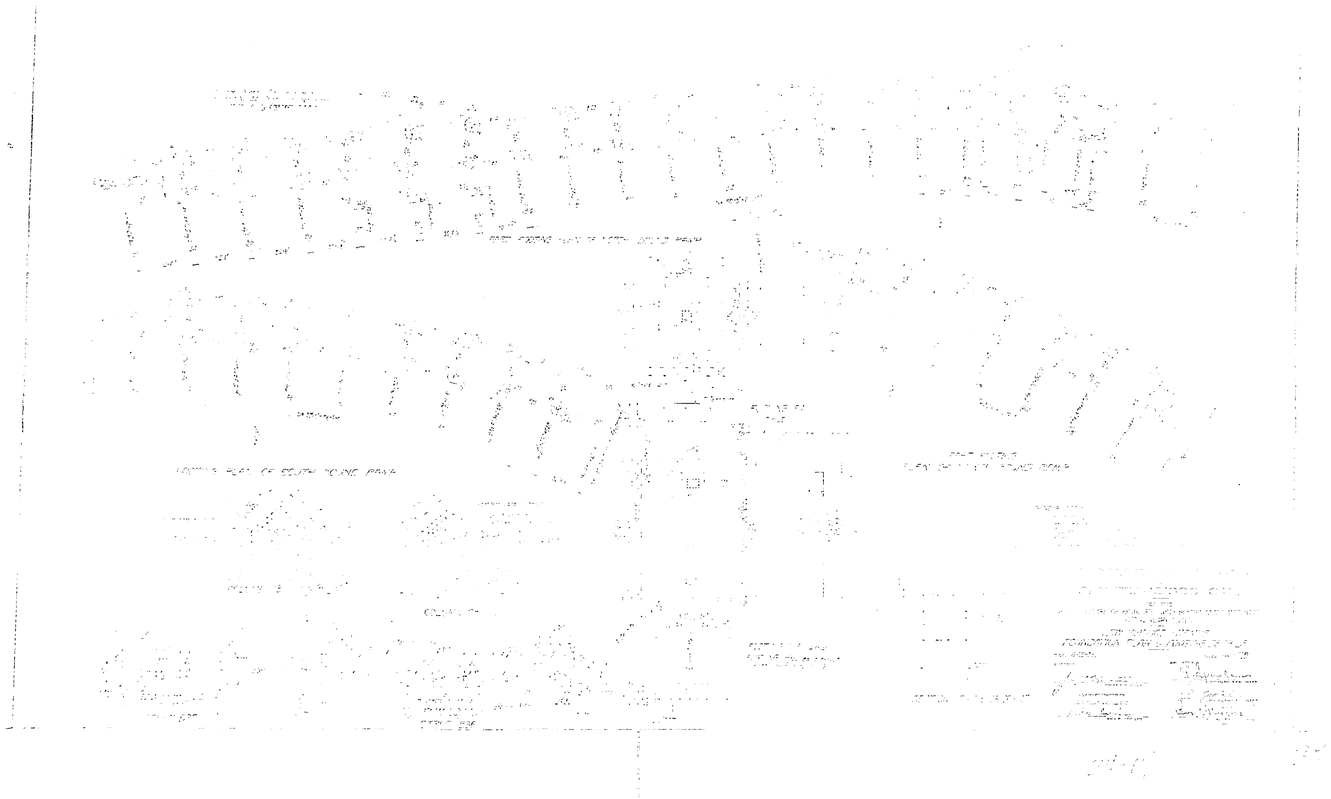

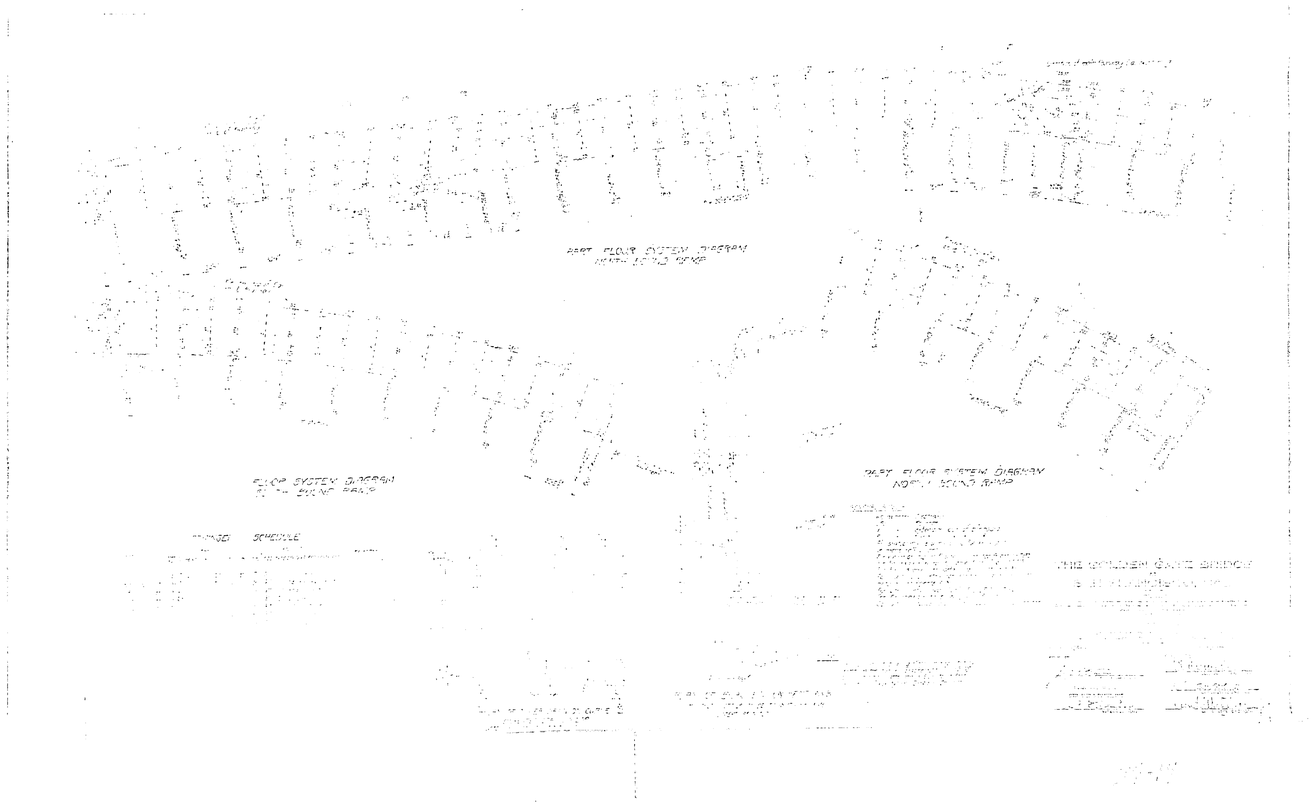

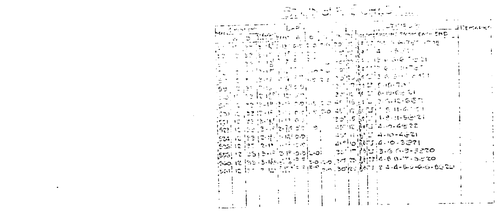

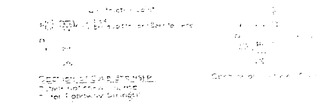

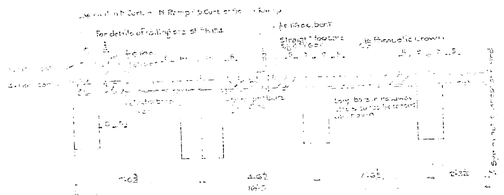

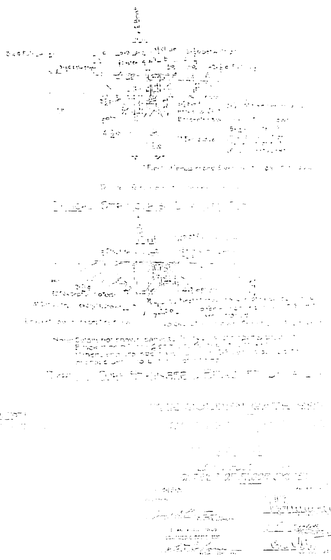

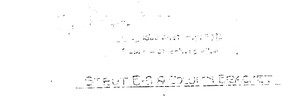

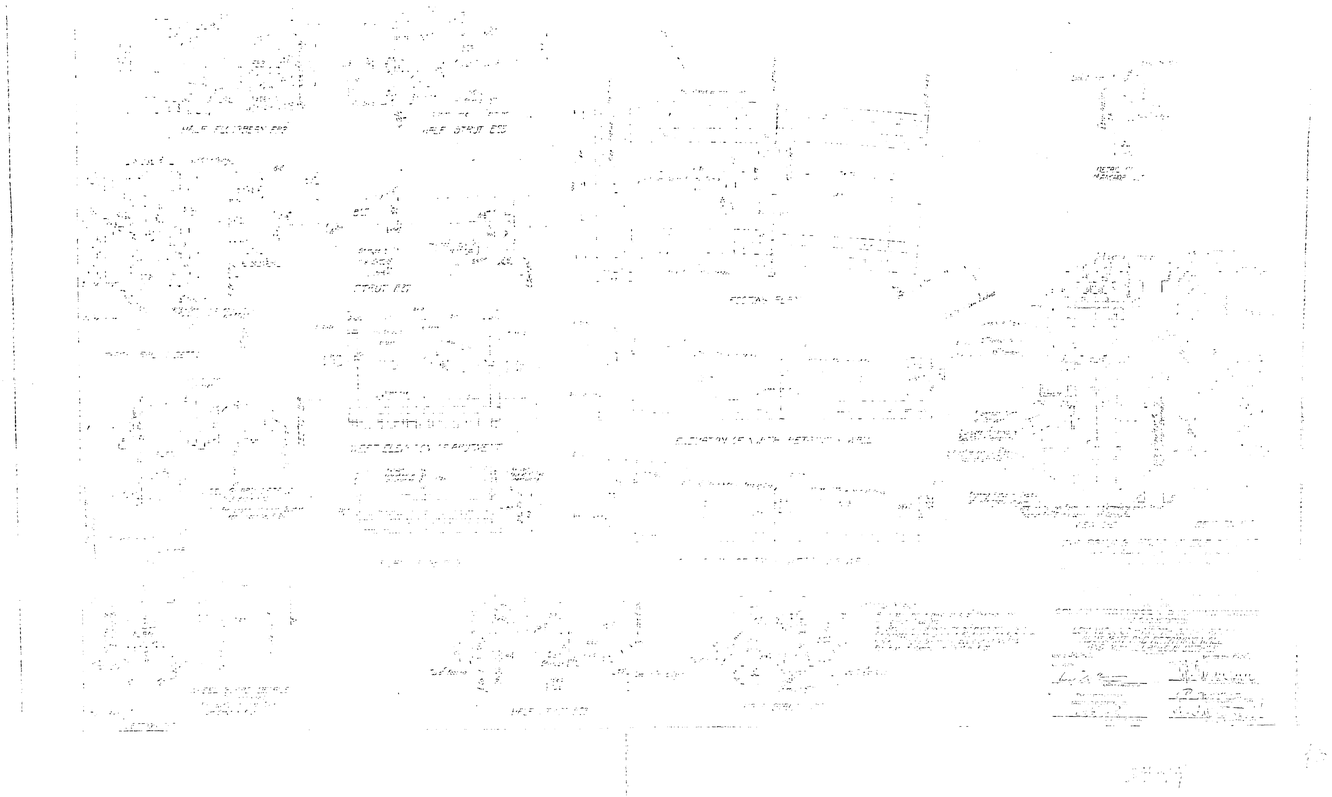

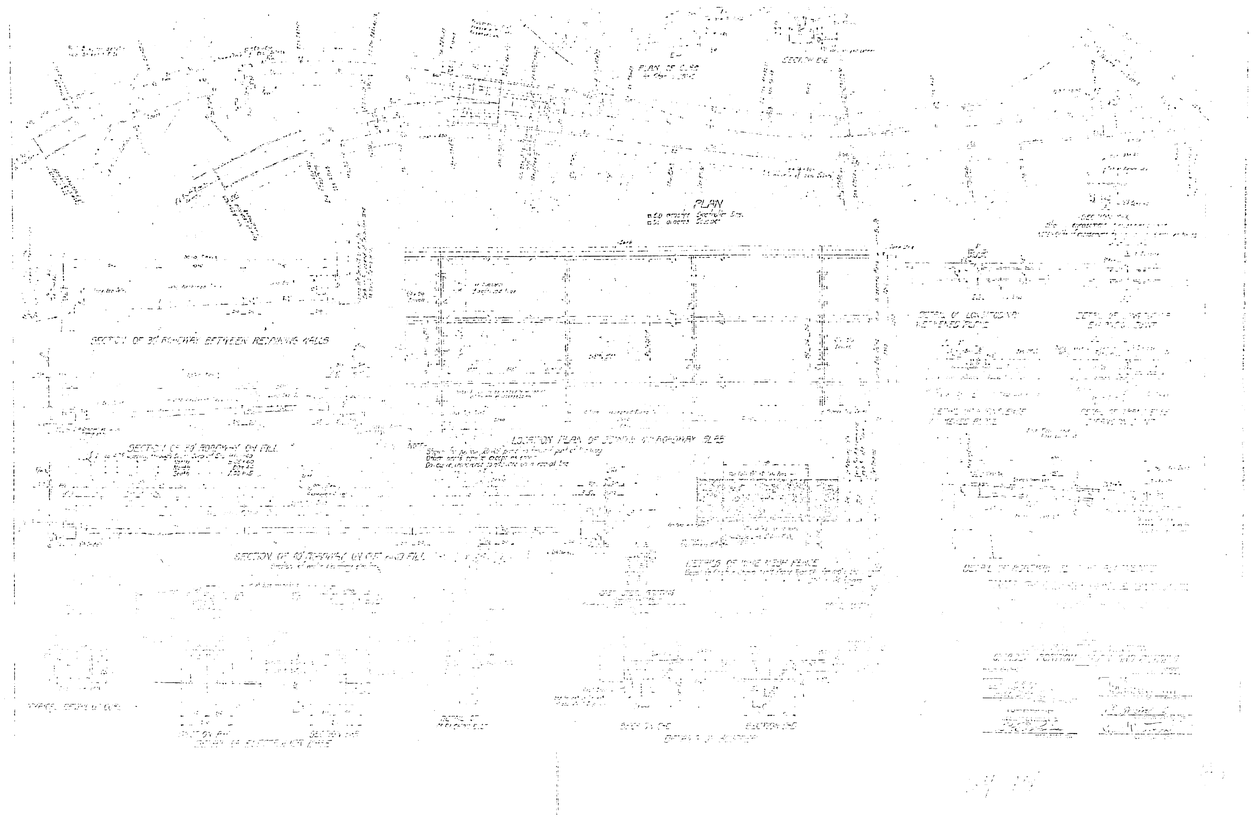 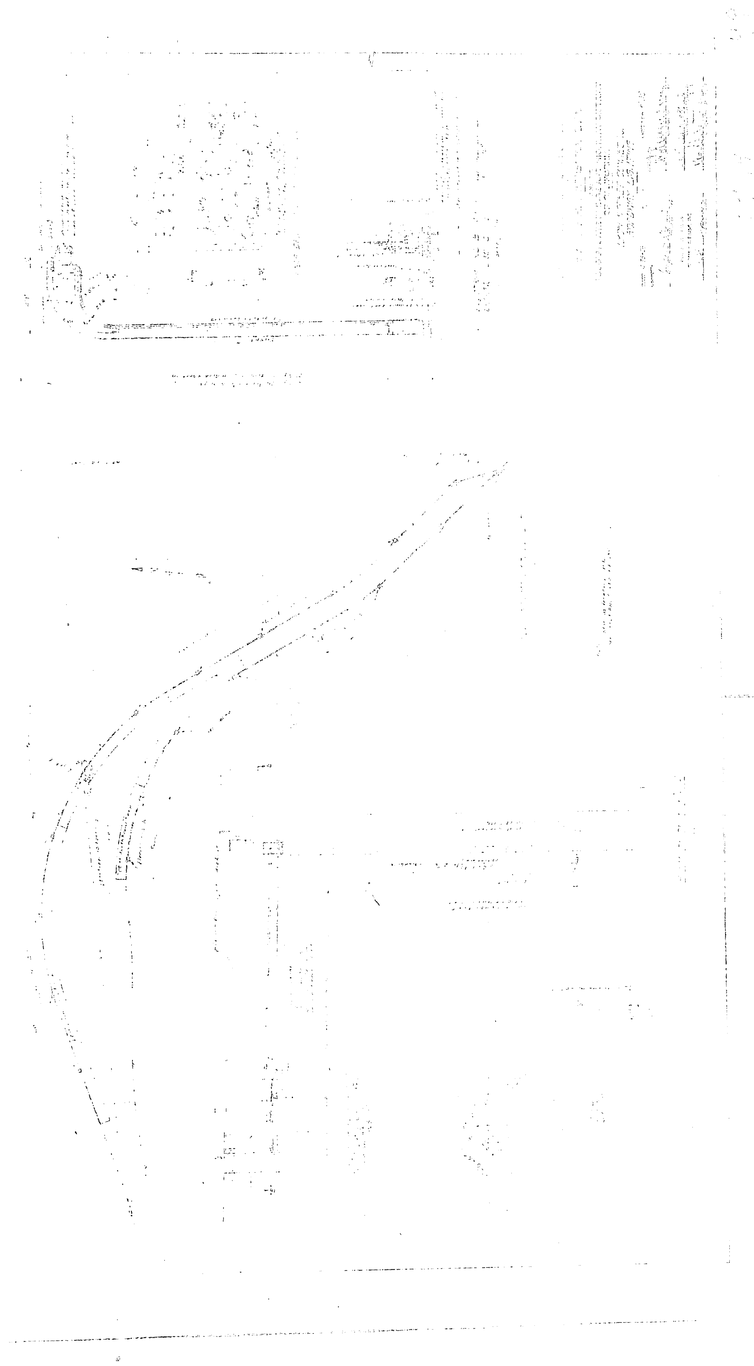
PLAN