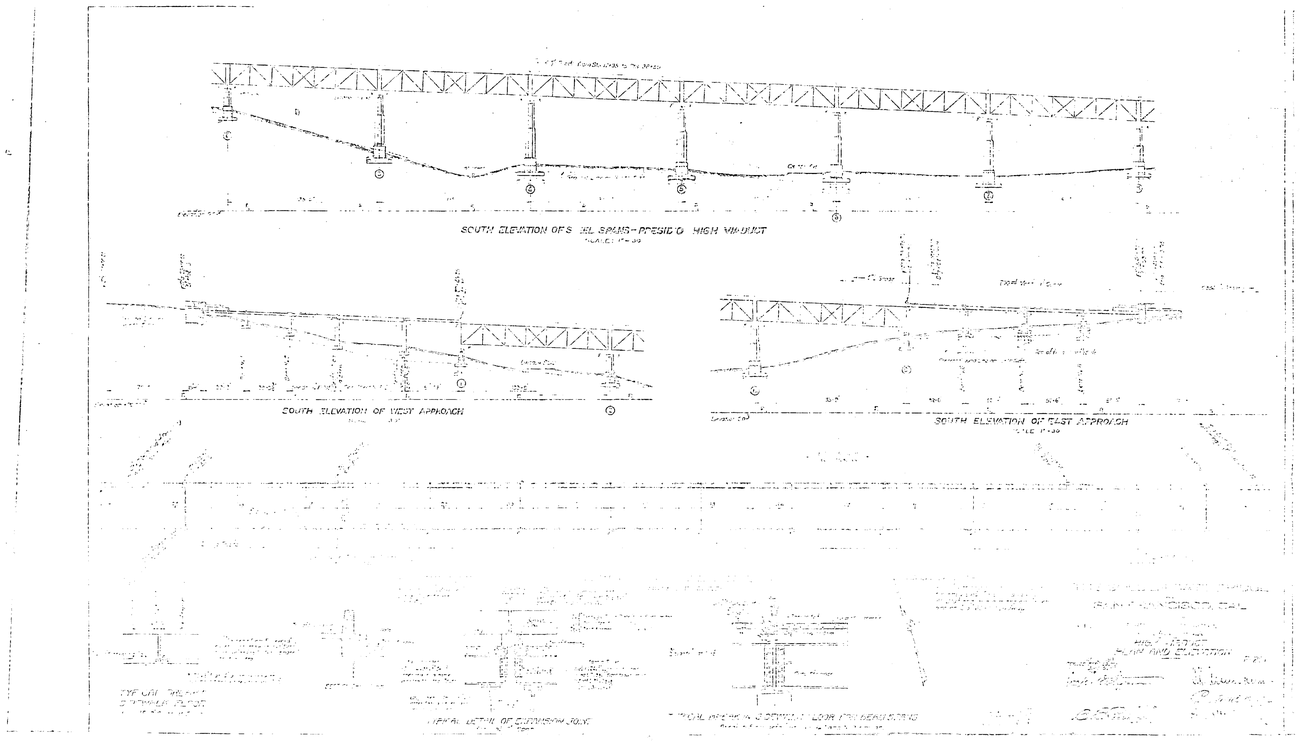
SOUTH ELEVATION OF WEST APPROACH
SOUTH ELEVATION OF EAST APPROACH

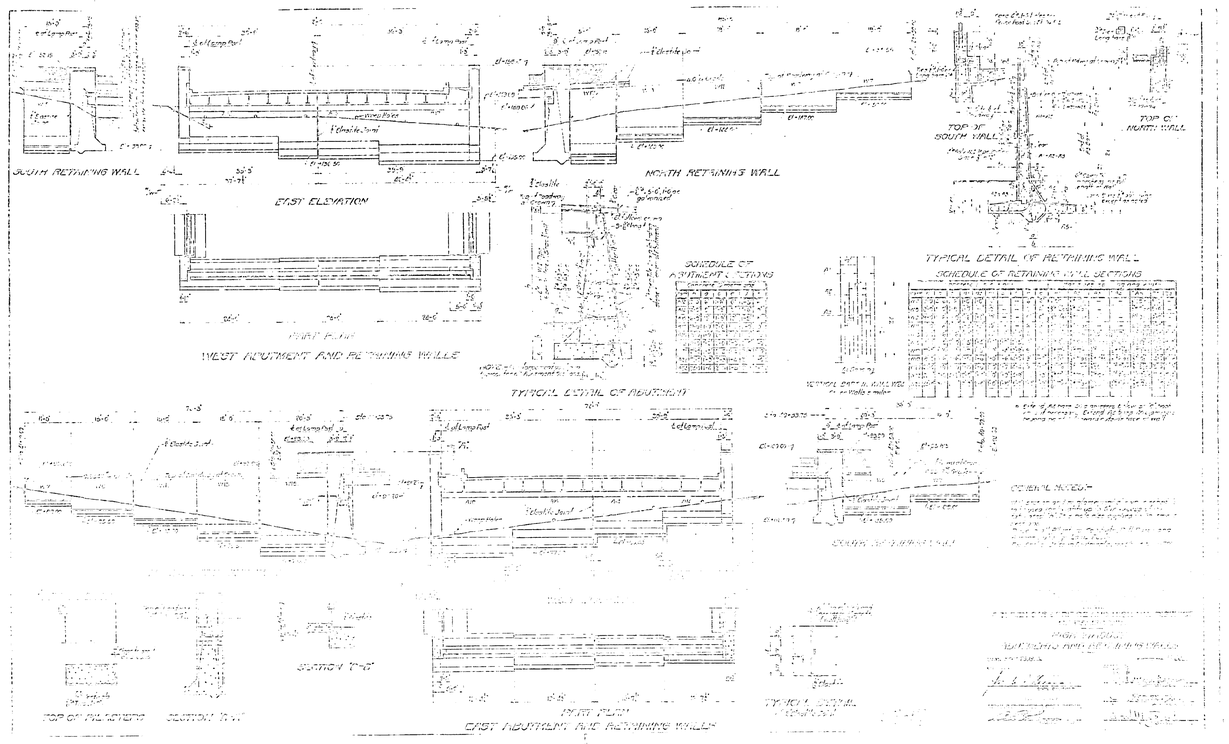
SOUTH RETAINING WALL
EAST ELEVATION
NORTH RETAINING WALL
TOP OF SOUTH WALL
TOP OF NORTH WALL
TYPICAL DETAIL OF RETAINING WALL
SCHEDULE OF RETAINING WALL SECTIONS
WEST ABUTMENT AND RETAINING WALLS
TYPICAL DETAIL OF ABUTMENT
GENERAL NOTES
SECTION "A-A"
EAST ABUTMENT AND RETAINING WALLS

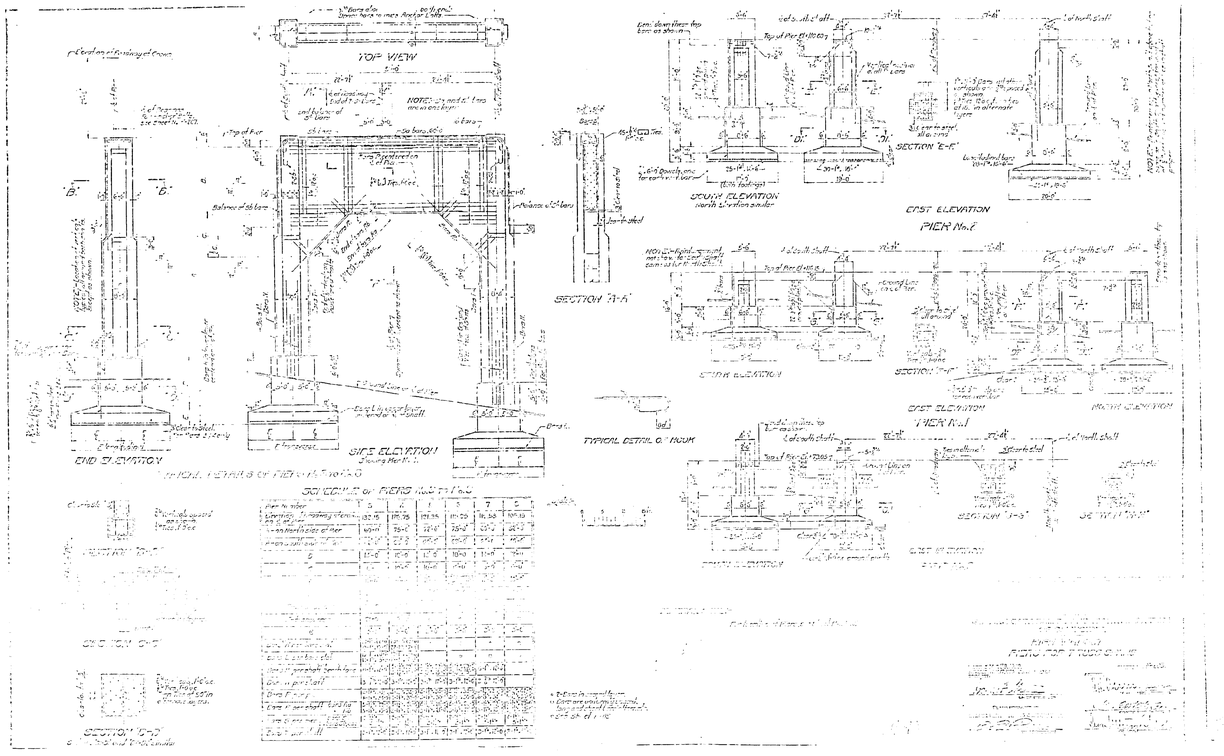
TOP VIEW
END ELEVATION
SIDE ELEVATION
SECTION "A-A"
SOUTH ELEVATION
EAST ELEVATION
PIER No. 2
PIER No. 1
TYPICAL DETAIL OF HOOK
SCHEDULE OF PIERS

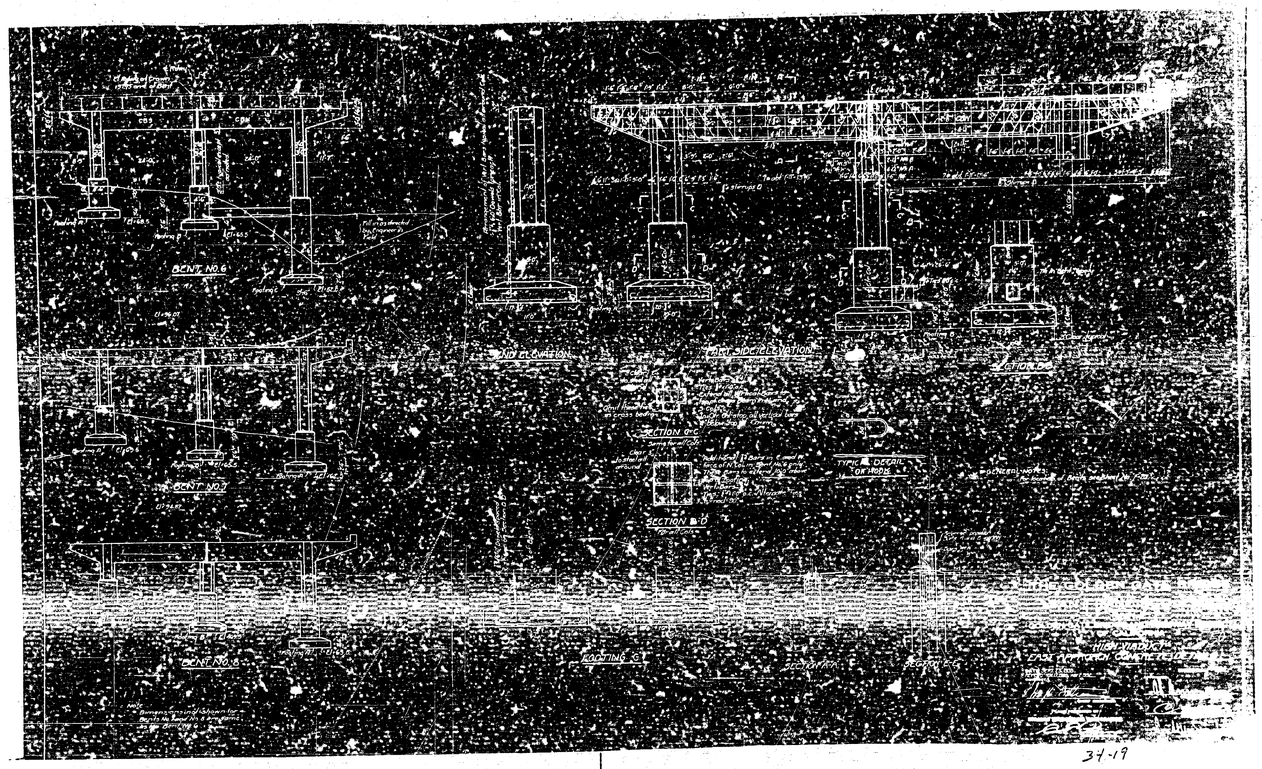

AS BUILT PLANS
Contract No. [illegible]
Date Completed
Document No. [illegible]

24X

I HEREBY CERTIFY THAT THIS IS A TRUE AND ACCURATE COPY OF THE ABOVE DOCUMENT TAKEN UNDER MY DIRECTION AND CONTROL ON THIS DATE IN SACRAMENTO, CALIFORNIA, PURSUANT TO AUTHORIZATION BY THE DIRECTOR OF TRANSPORTATION.

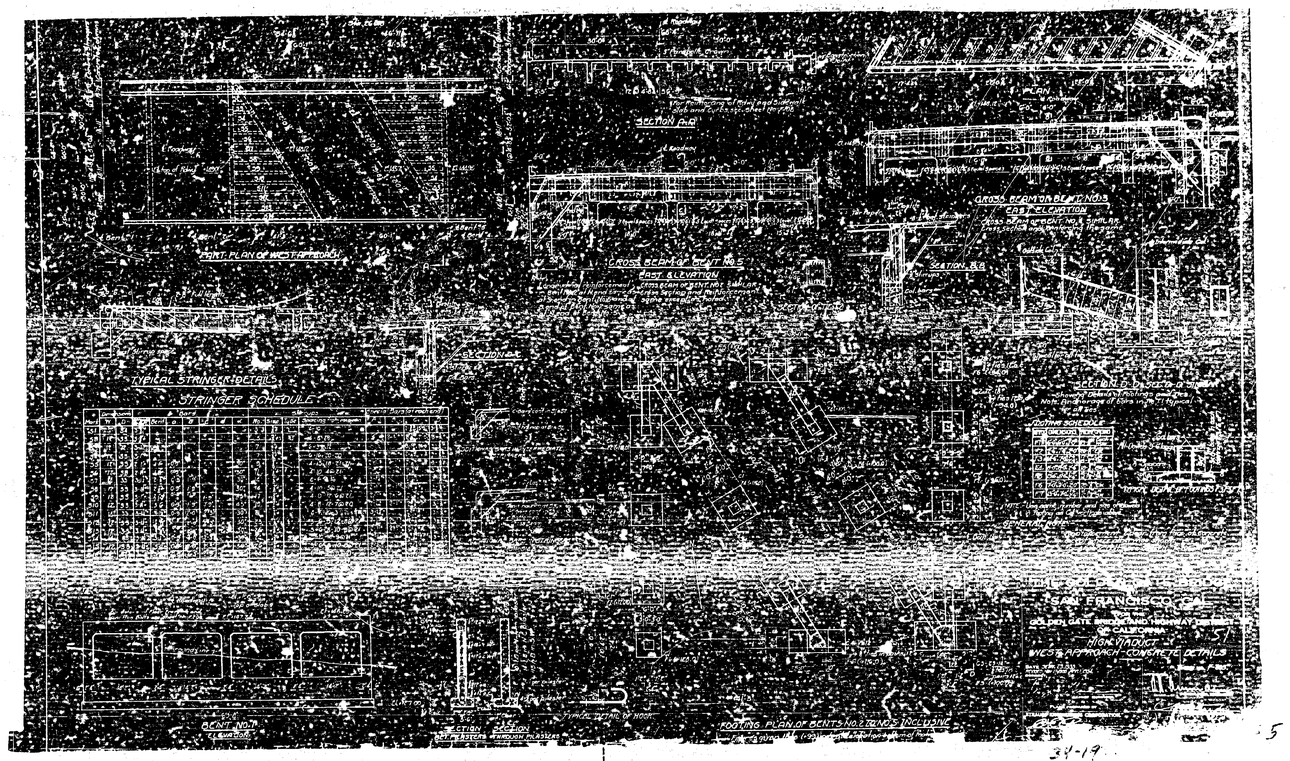

AS BUILT PLANS
Contract No. [illegible]
Date Completed
Document No. [illegible]

24X

I HEREBY CERTIFY THAT THIS IS A TRUE AND ACCURATE COPY OF THE ABOVE DOCUMENT PRINTED UNDER MY DIRECTION AND CONTROL ON THIS DATE IN SACRAMENTO, CALIFORNIA PURSUANT TO AUTHORIZATION BY THE DIRECTOR OF TRANSPORTATION.

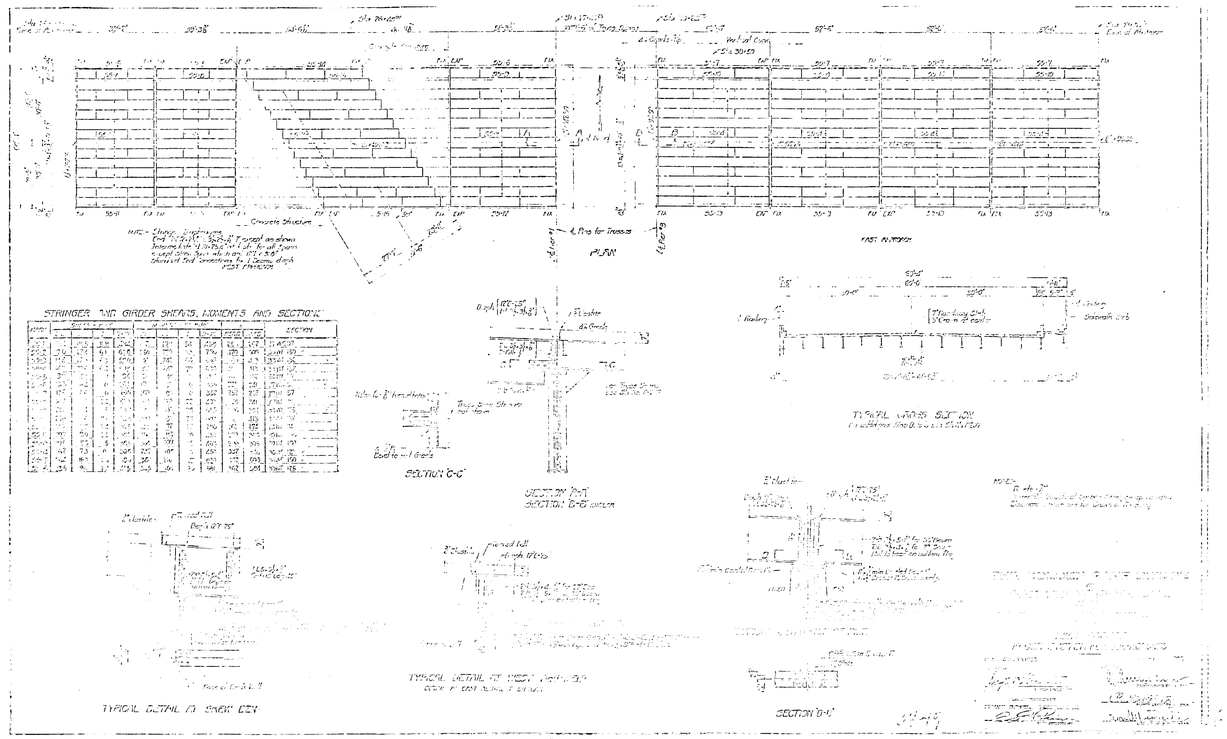
PLAN
STRINGER AND GIRDER SHEARS, MOMENTS AND SECTIONS
SECTION C-C'
SECTION B-B'
TYPICAL CROSS SECTION
TYPICAL DETAIL AT SKEW BEN
SECTION D-D'

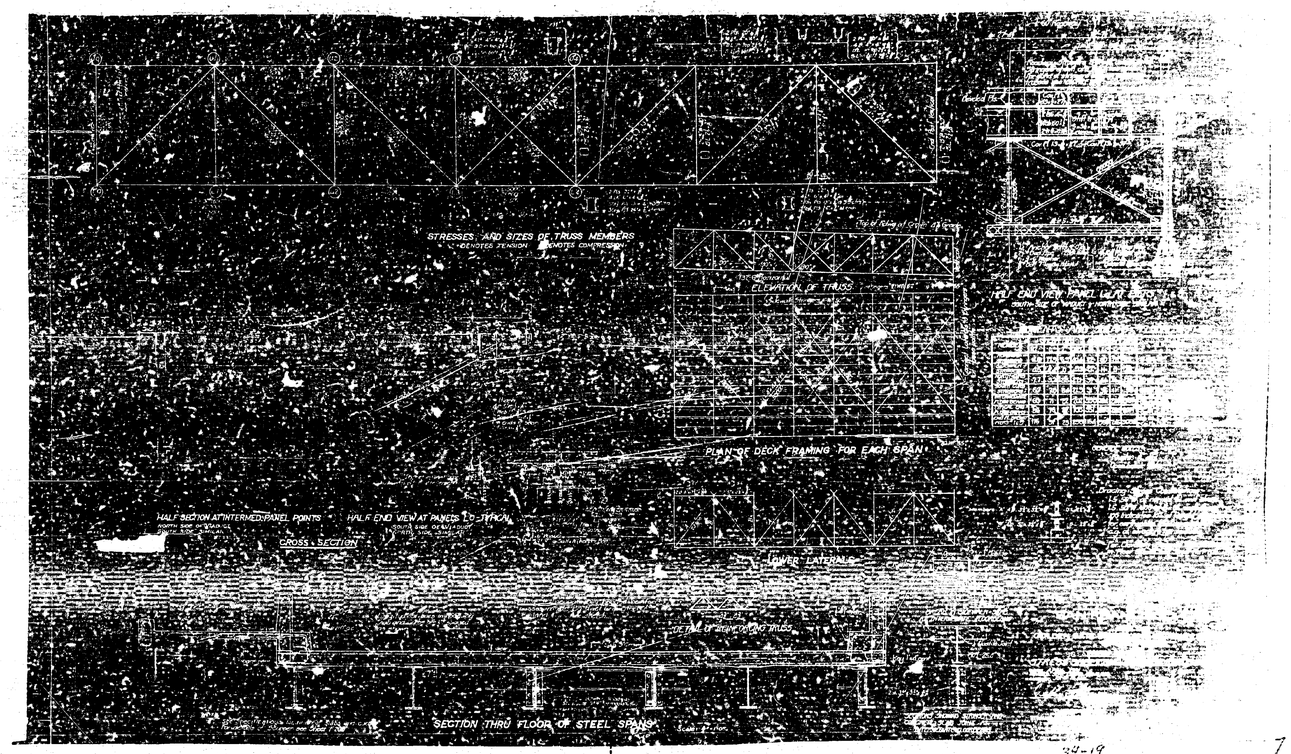

34-19

7

AS BUILT PLANS
Contract No. UNKNOWN
Date Completed
Document No. [illegible]

24X

I HEREBY CERTIFY THAT THIS IS A TRUE AND ACCURATE COPY OF THE ABOVE DOCUMENT [illegible] UNDER MY DIRECTION AND CONTROL ON THIS DATE IN SACRAMENTO, CALIFORNIA, PERMITTED TO AUTHORIZATION BY THE DIRECTOR OF TRANSPORTATION

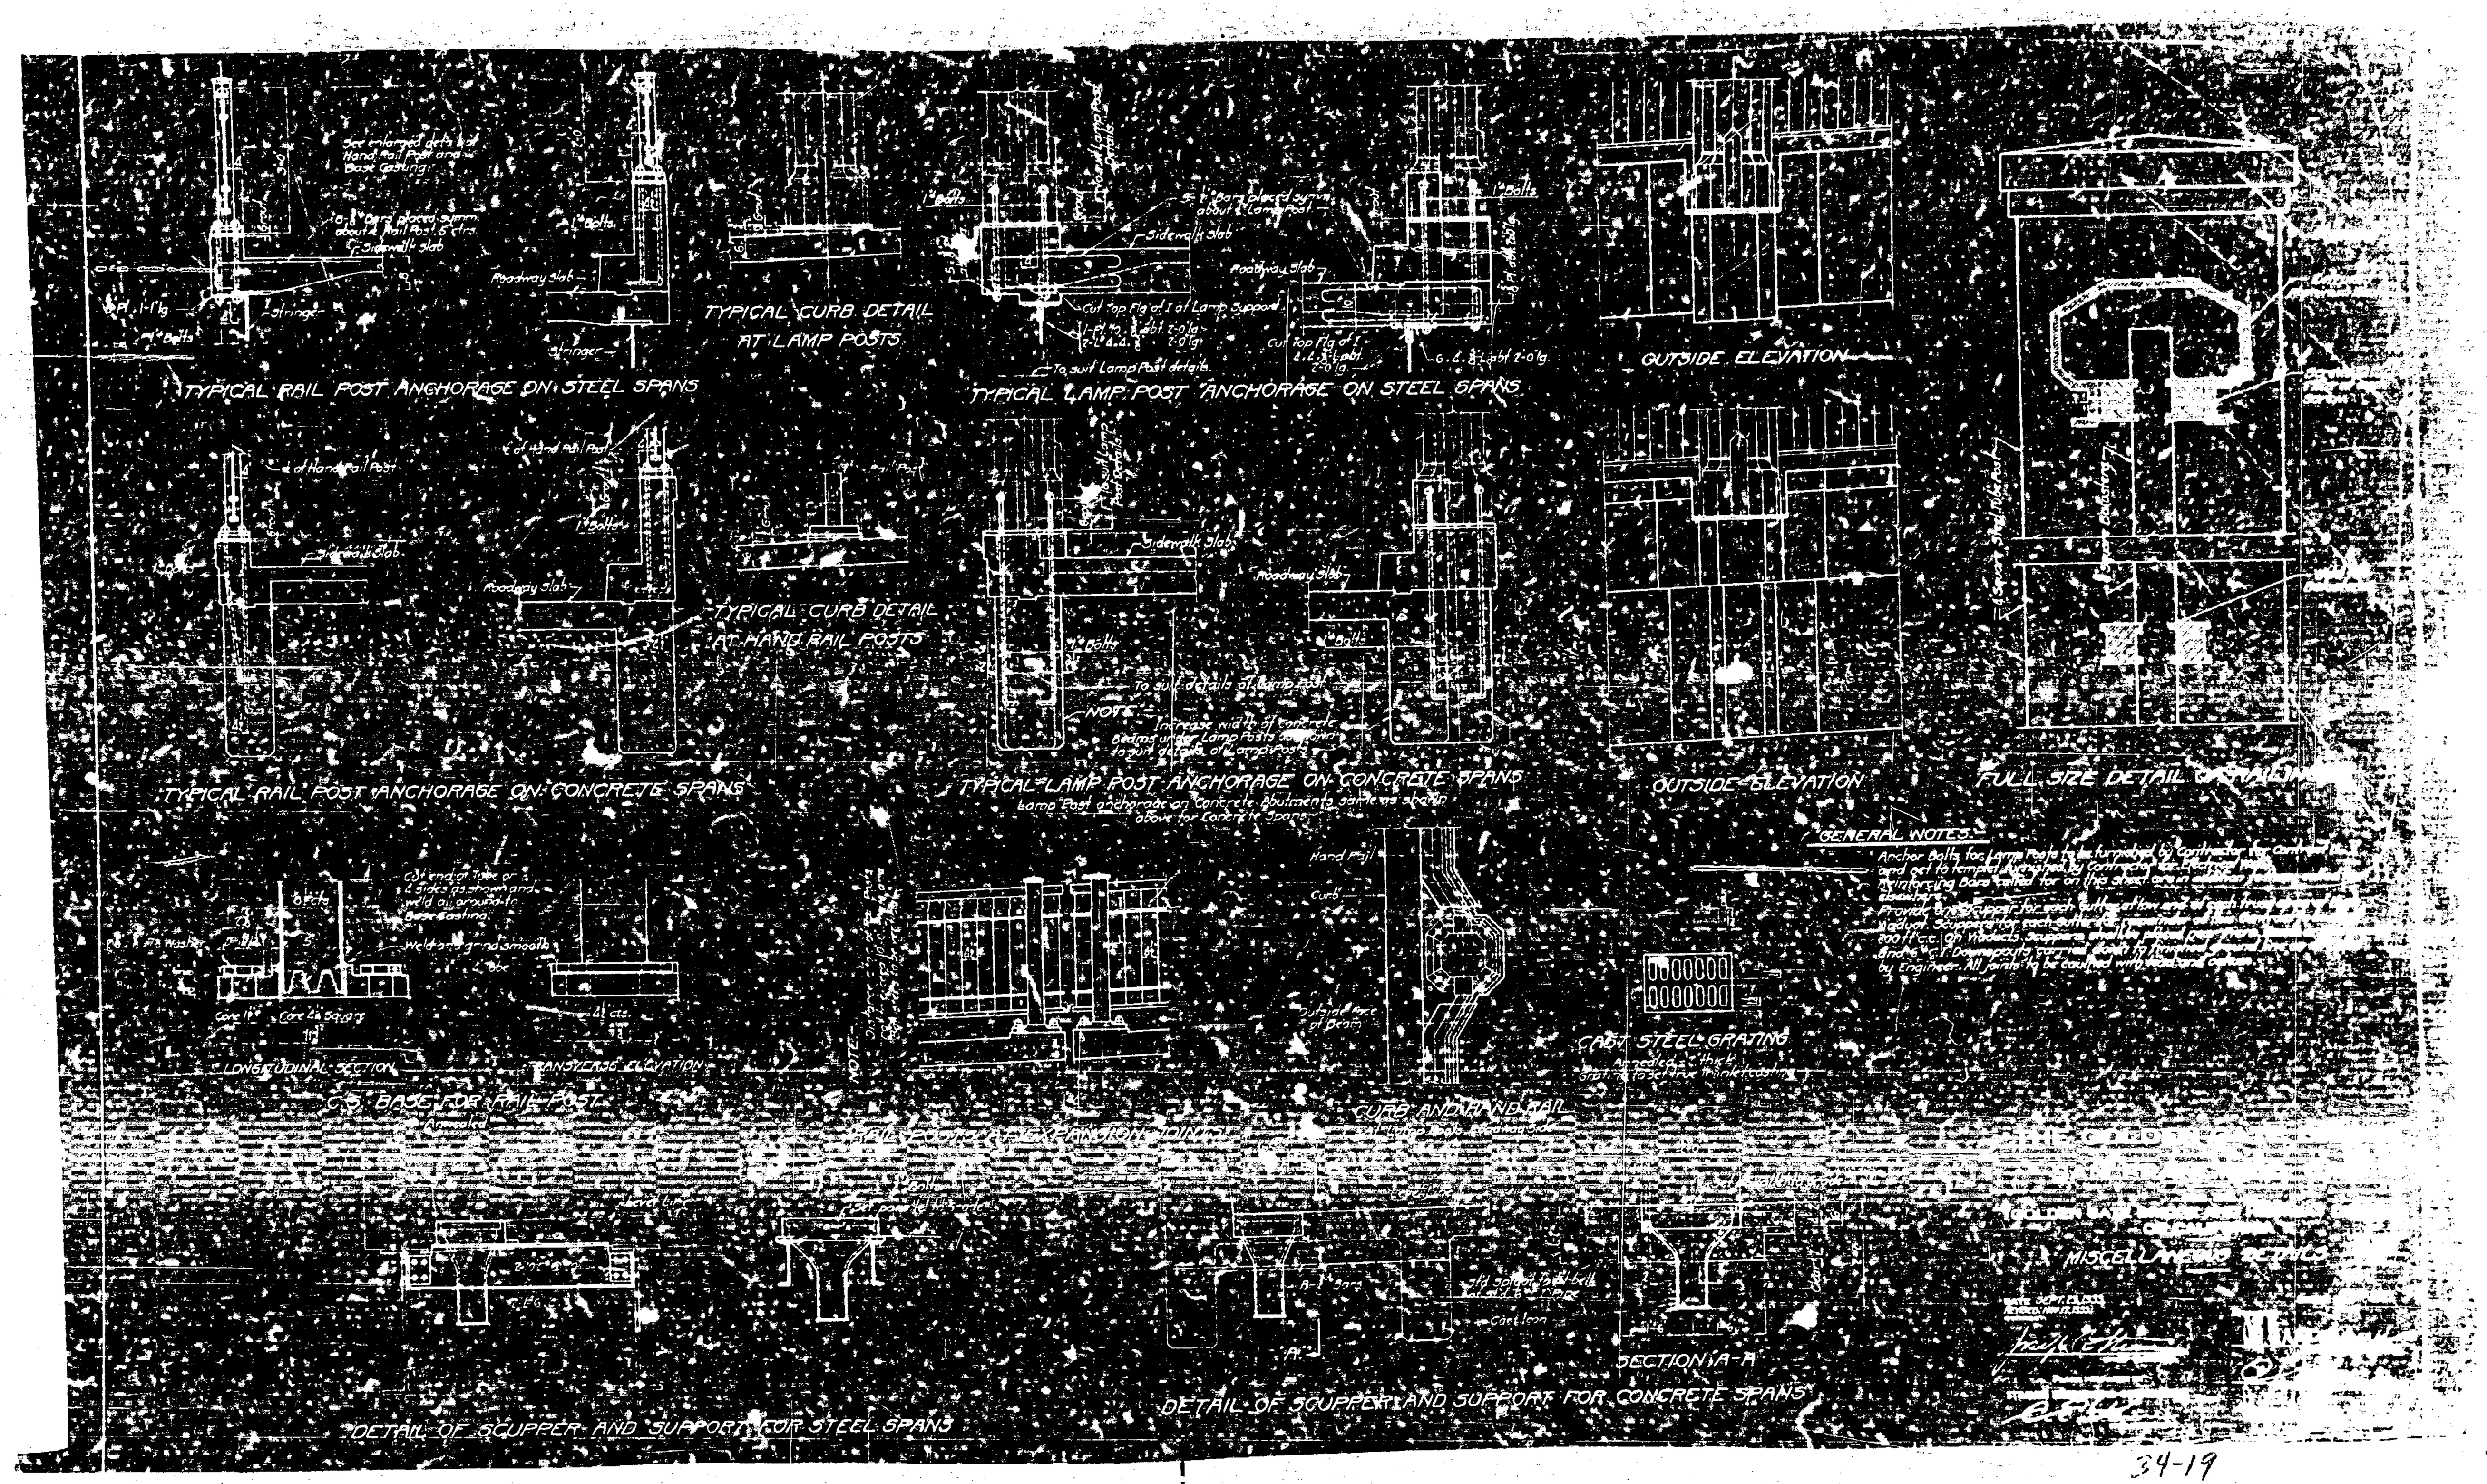

34-19

8

AS BUILT PLANS
Contract No UNKNOWN
Date Completed ____
Document No

24X

I HEREBY CERTIFY THAT THIS IS A TRUE AND ACCURATE COPY OF THE ABOVE DOCUMENT TAKEN UNDER MY DIRECTION AND CONTROL ON THIS DATE IN SACRAMENTO, CALIFORNIA PURSUANT TO AUTHORIZATION BY THE DIRECTOR OF TRANSPORTATION.

34-19

AS BUILT PLANS
Contract No. [illegible]
Date Completed [illegible]
Document No. [illegible]

24X

I HEREBY CERTIFY THAT THIS IS A TRUE AND ACCURATE COPY OF THE ABOVE DOCUMENT TAKEN UNDER MY DIRECTION AND CONTROL ON THIS DATE, IN SACRAMENTO, CALIFORNIA PURSUANT TO AUTHORIZATION BY THE DIRECTOR OF TRANSPORTATION.
SIGNATURE
DATE

 

10

34-19

AS BUILT PLANS
Contract No UNKNOWN
Date Completed
Document No [illegible]

24X

I HEREBY CERTIFY THAT THIS IS A TRUE AND ACCURATE COPY OF THE ABOVE DOCUMENT TAKEN UNDER MY DIRECTION AND CONTROL ON THIS DATE IN SACRAMENTO, CALIFORNIA PURSUANT TO AUTHORIZATION BY THE DIRECTOR OF TRANSPORTATION

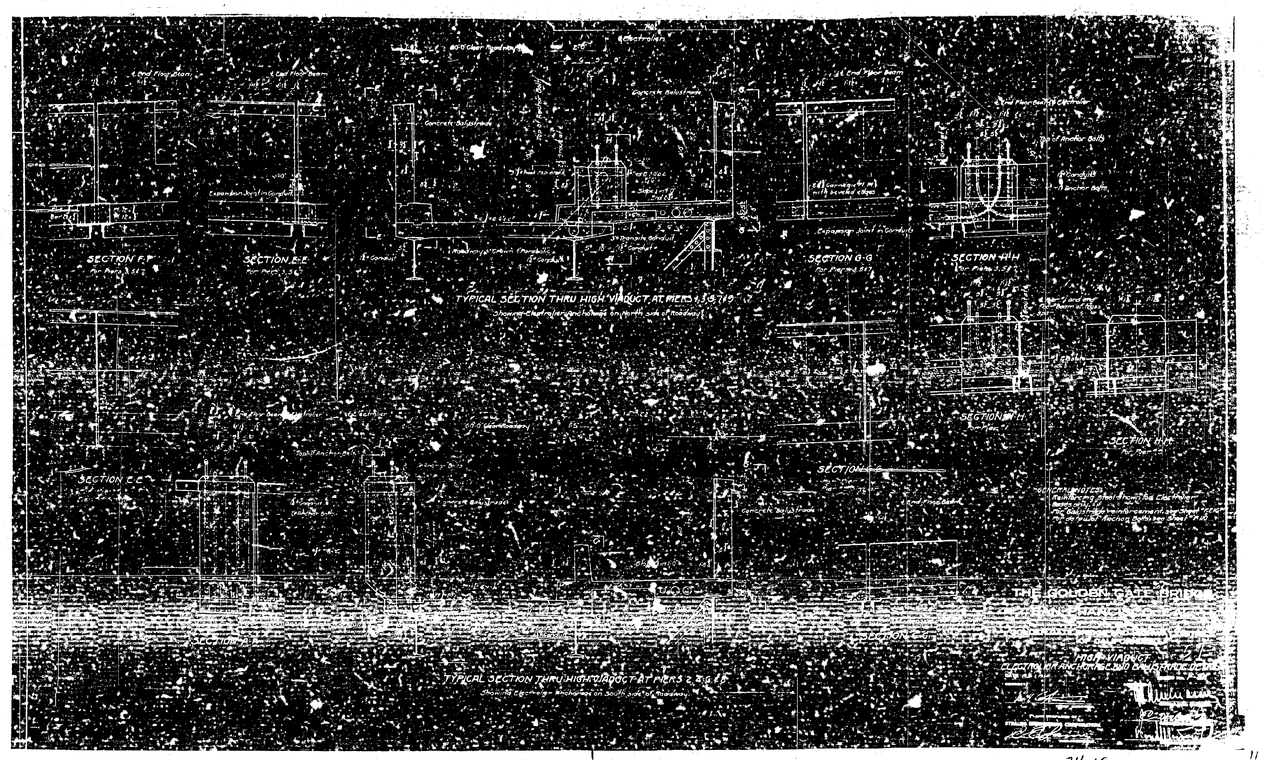

34-19

AS BUILT PLANS
Contract No. UNKNOWN
Date Completed
Document No. [illegible]

24X

I HEREBY CERTIFY THAT THIS IS A TRUE AND ACCURATE COPY OF THE ABOVE DOCUMENT, AND IS UNDER MY DIRECTION AND CONTROL ON THIS DATE IN SACRAMENTO, CALIFORNIA, PURSUANT TO AUTHORIZATION BY THE DIRECTOR OF TRANSPORTATION.

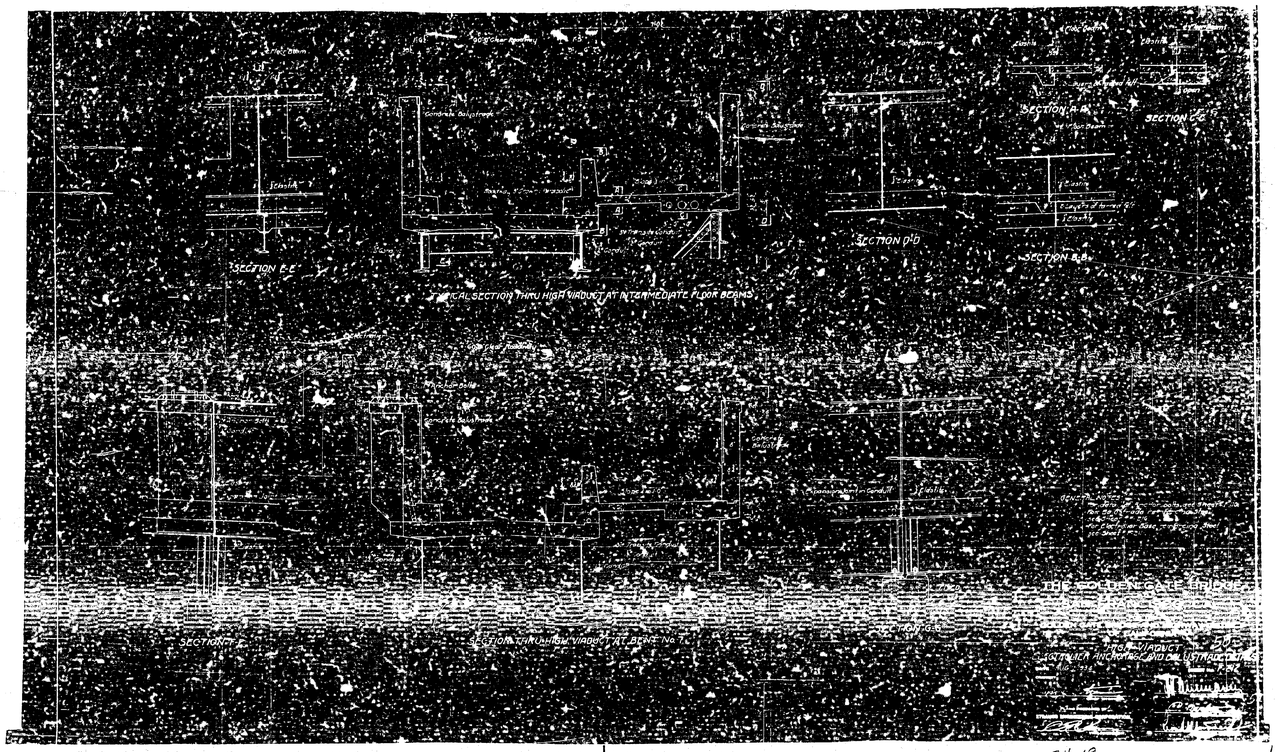

34-19

12

AS BUILT PLANS
Contract No. UNKNOWN
Date Completed
Document No. [illegible]

24X

I HEREBY CERTIFY THAT THIS IS A TRUE AND ACCURATE COPY OF THE AS BUILT DOCUMENT TAKEN UNDER MY DIRECTION AND CONTROL ON THE DATE IN SACRAMENTO, CALIFORNIA PURSUANT TO AUTHORIZATION BY THE DIRECTOR OF TRANSPORTATION.
DATE
SIGNATURE
TITLE

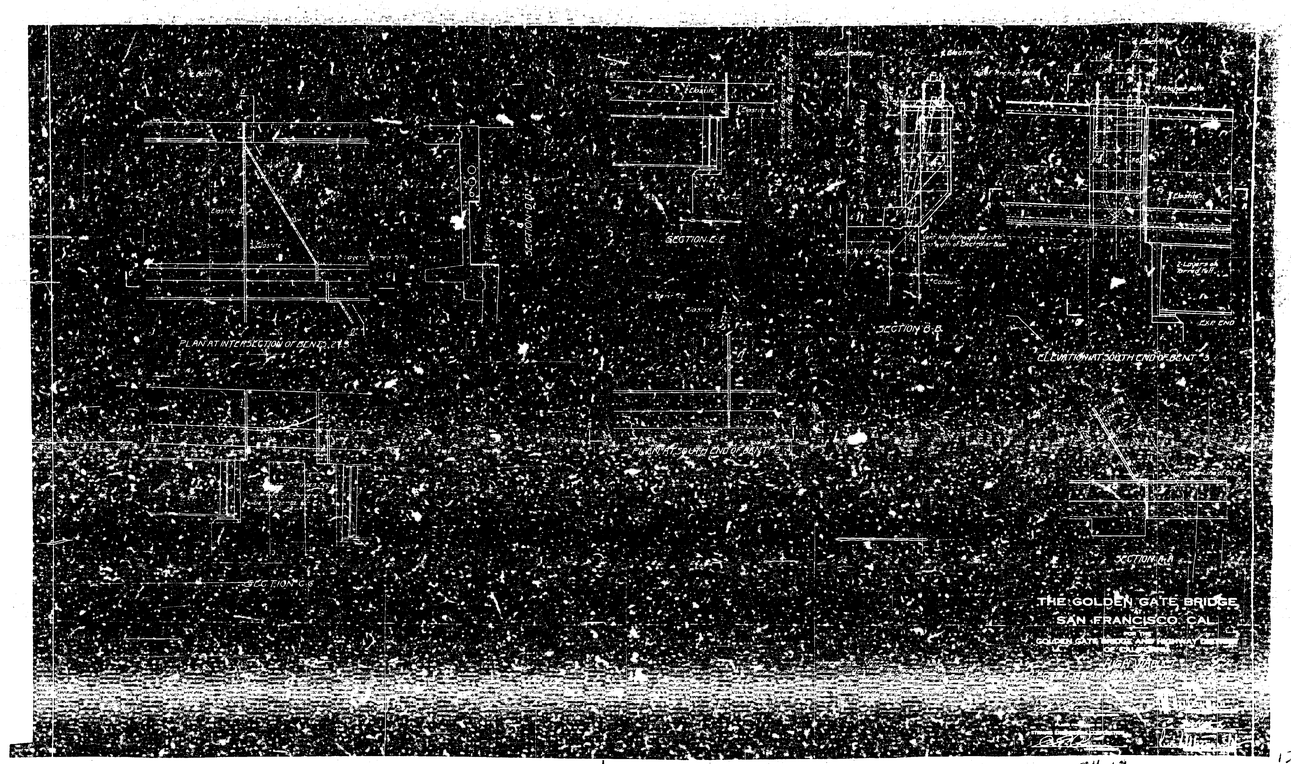

34-17

AS BUILT PLANS
Contract No. UNKNOWN
Date Completed
Document No. [illegible]

24X

I HEREBY CERTIFY THAT THIS IS A TRUE AND ACCURATE COPY OF THE ABOVE DOCUMENT TAKEN UNDER MY DIRECTION AND CONTROL ON THIS DATE IN ACCORDANCE, CAUTIONS, PURSUANT TO AUTHORIZATION BY THE DIRECTOR OF TRANSPORTATION.

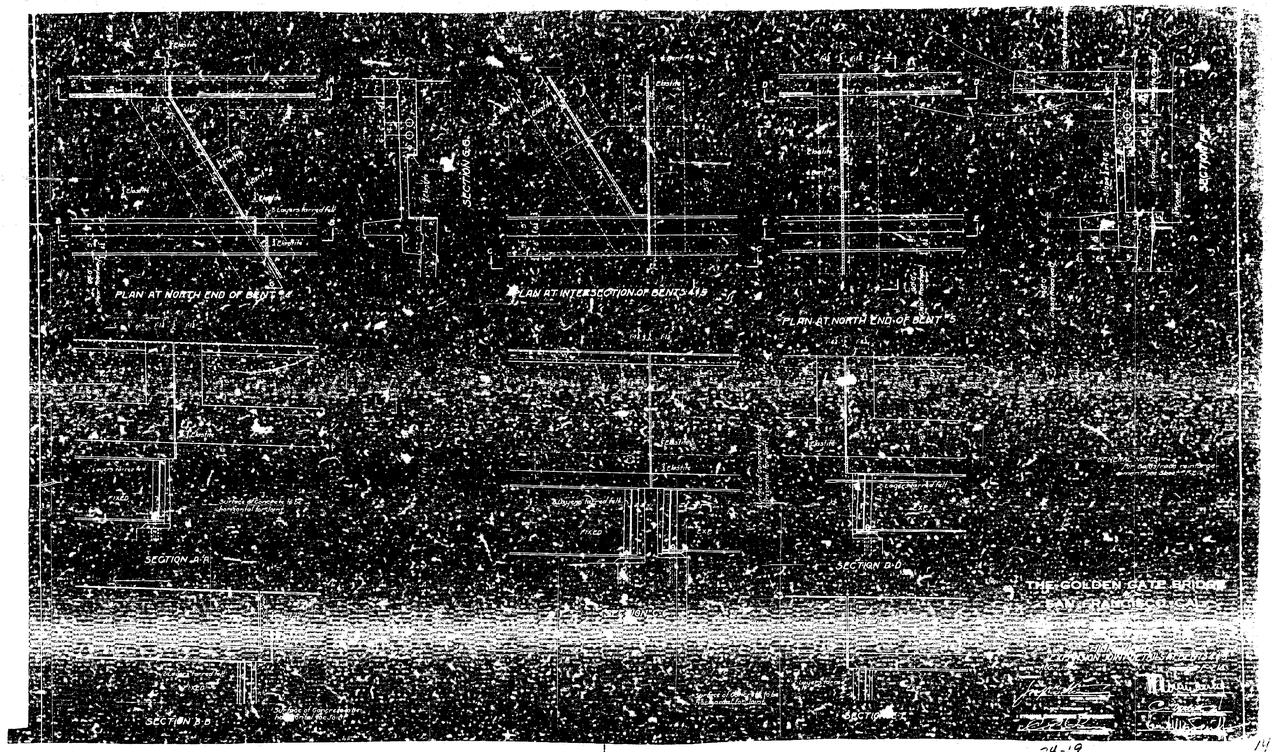

34-19

14

AS BUILT PLANS
Contract No. [illegible]
Date Completed [illegible]
Document No. [illegible]

24X

I HEREBY CERTIFY THAT THIS IS A TRUE AND ACCURATE COPY OF THE ABOVE DOCUMENT TAKEN UNDER MY DIRECTION AND CONTROL ON THIS DATE IN SACRAMENTO, CALIFORNIA PURSUANT TO AUTHORIZATION BY THE DIRECTOR OF TRANSPORTATION.
DATE
SIGNATURE

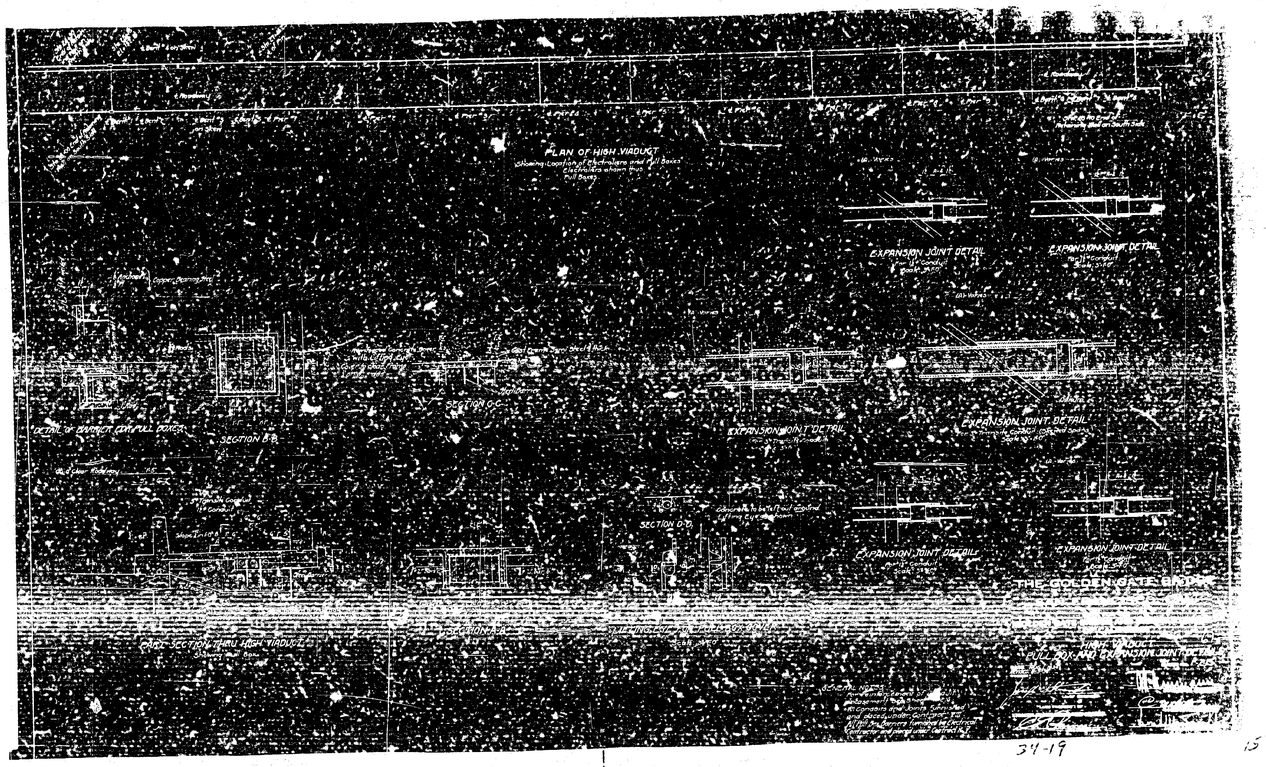

34-19

15

AS BUILT PLANS
Contract No. [illegible]
Date Completed [illegible]
Document No. [illegible]

24X

I HEREBY CERTIFY THAT THIS IS A TRUE AND ACCURATE COPY OF THE ABOVE DOCUMENT DRAWN UNDER MY DIRECTION AND COMPLETED ON THIS DATE IN SACRAMENTO, CALIFORNIA PURSUANT TO AUTHORIZATION BY THE DIRECTOR OF TRANSPORTATION.
DATE
SIGNATURE
TITLE

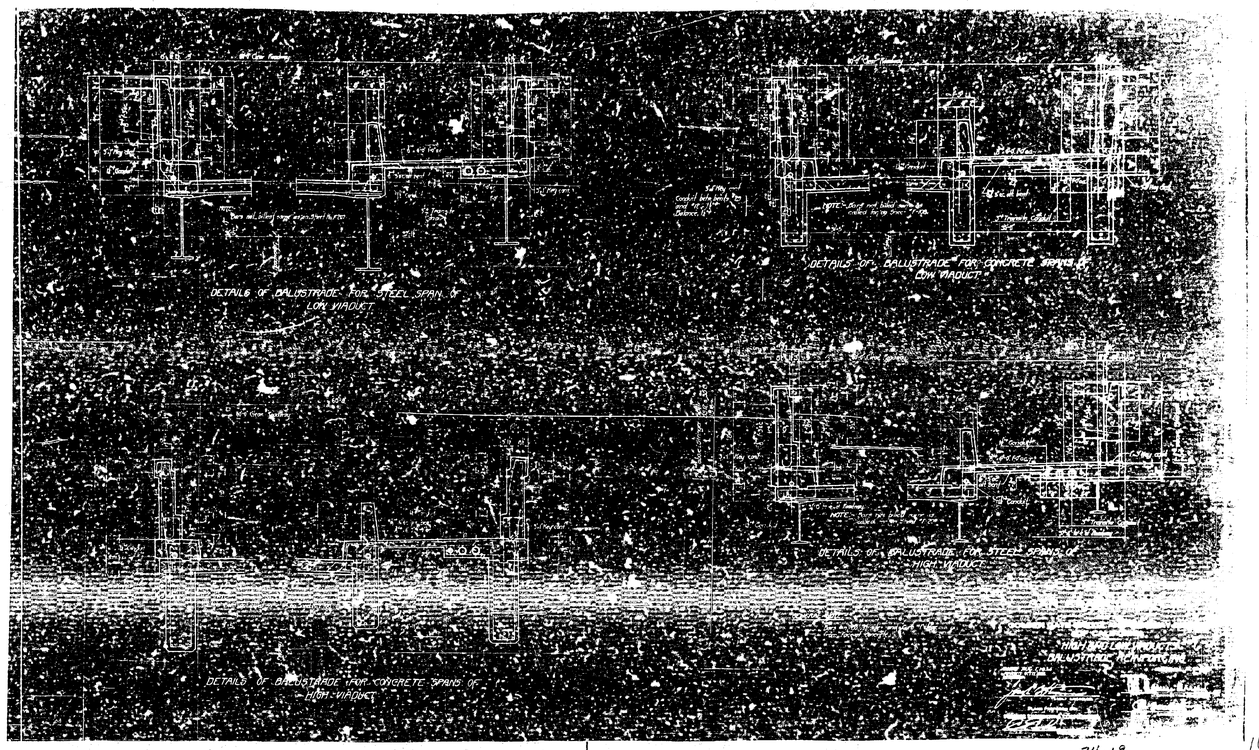

34-19

16

AS BUILT PLANS
Contract No. UNKNOWN
Date Completed
Document No.

24X

I HEREBY CERTIFY THAT THIS IS A TRUE AND ACCURATE COPY OF THE ORIGINAL DOCUMENT PAPER. ENDED BY DIRECTION AND CONTROL ON THIS DATE IN SACRAMENTO, CALIFORNIA, PURSUANT TO AUTHORIZATION BY THE DIRECTOR OF TRANSPORTATION.

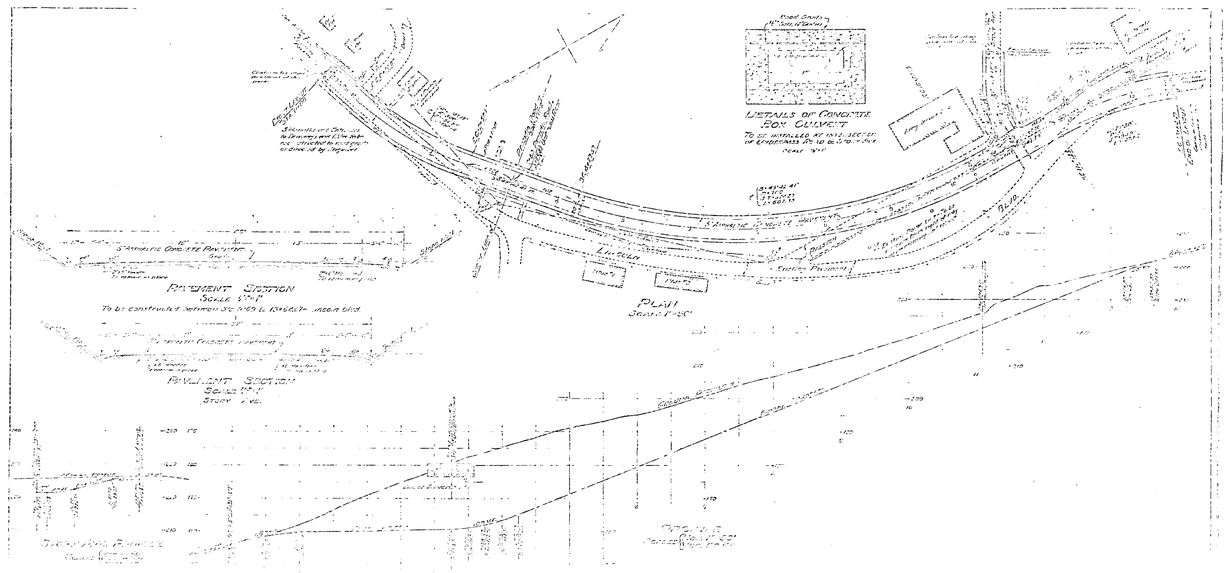
DETAILS OF CONCRETE BOX CULVERT
PAVEMENT SECTION
SCALE 1"=1'
PLAN
SCALE 1"=50'
PAVEMENT SECTION
SCALE 1"=1'

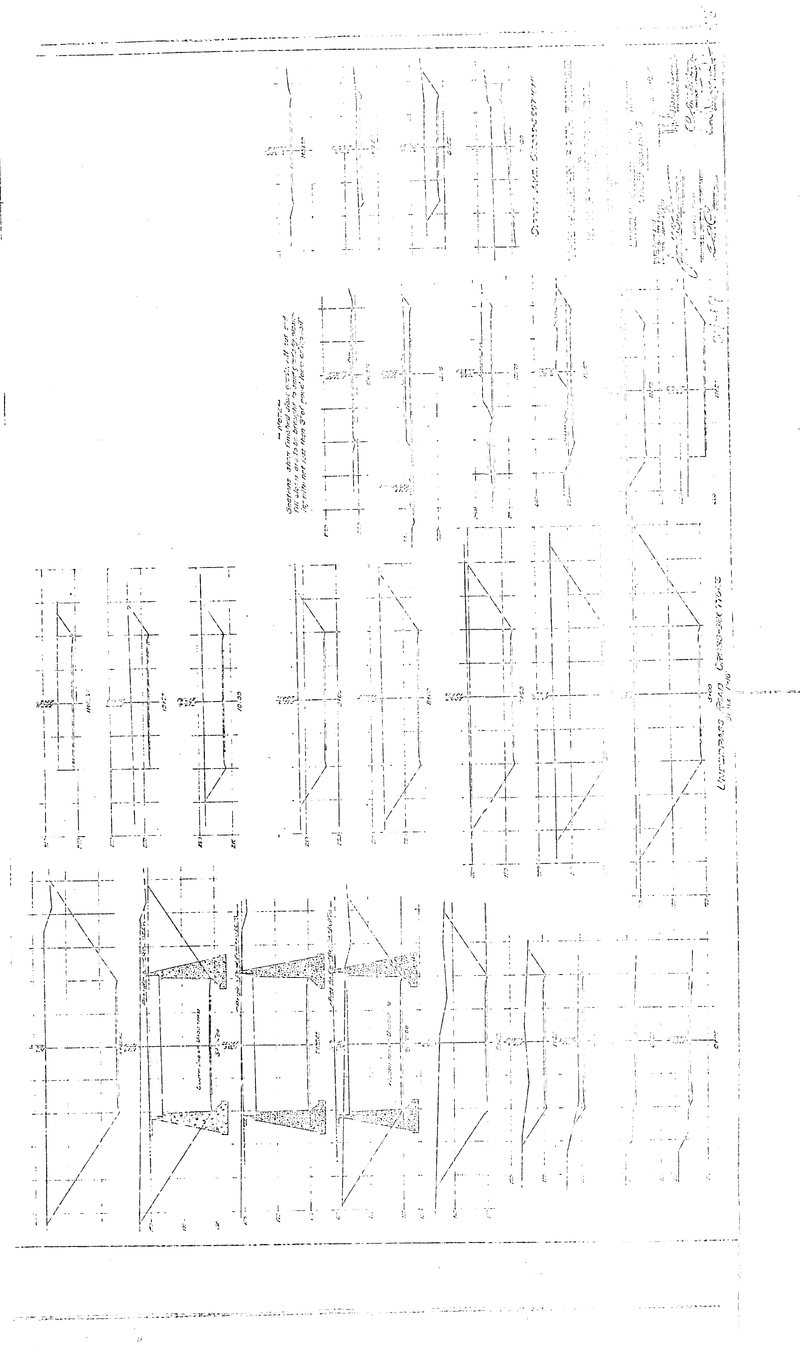

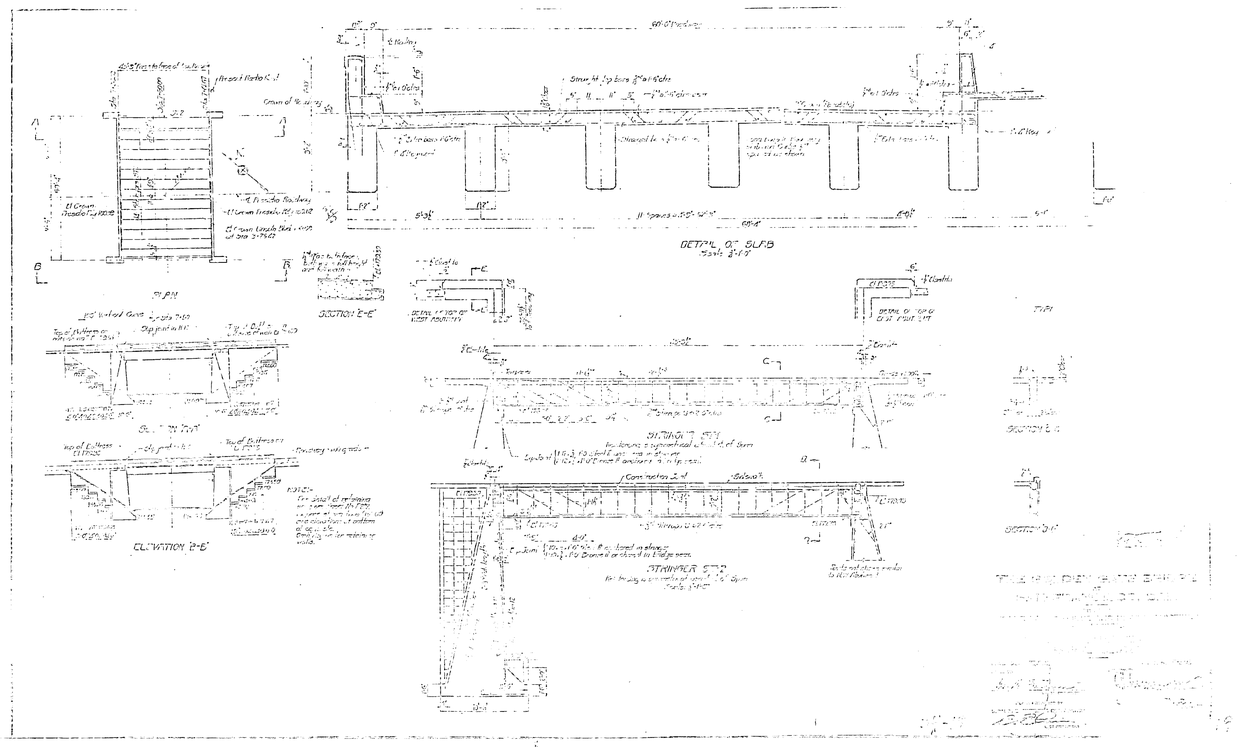
DETAIL OF SLAB
SECTION E-E
ELEVATION E-E
STAIRWAY

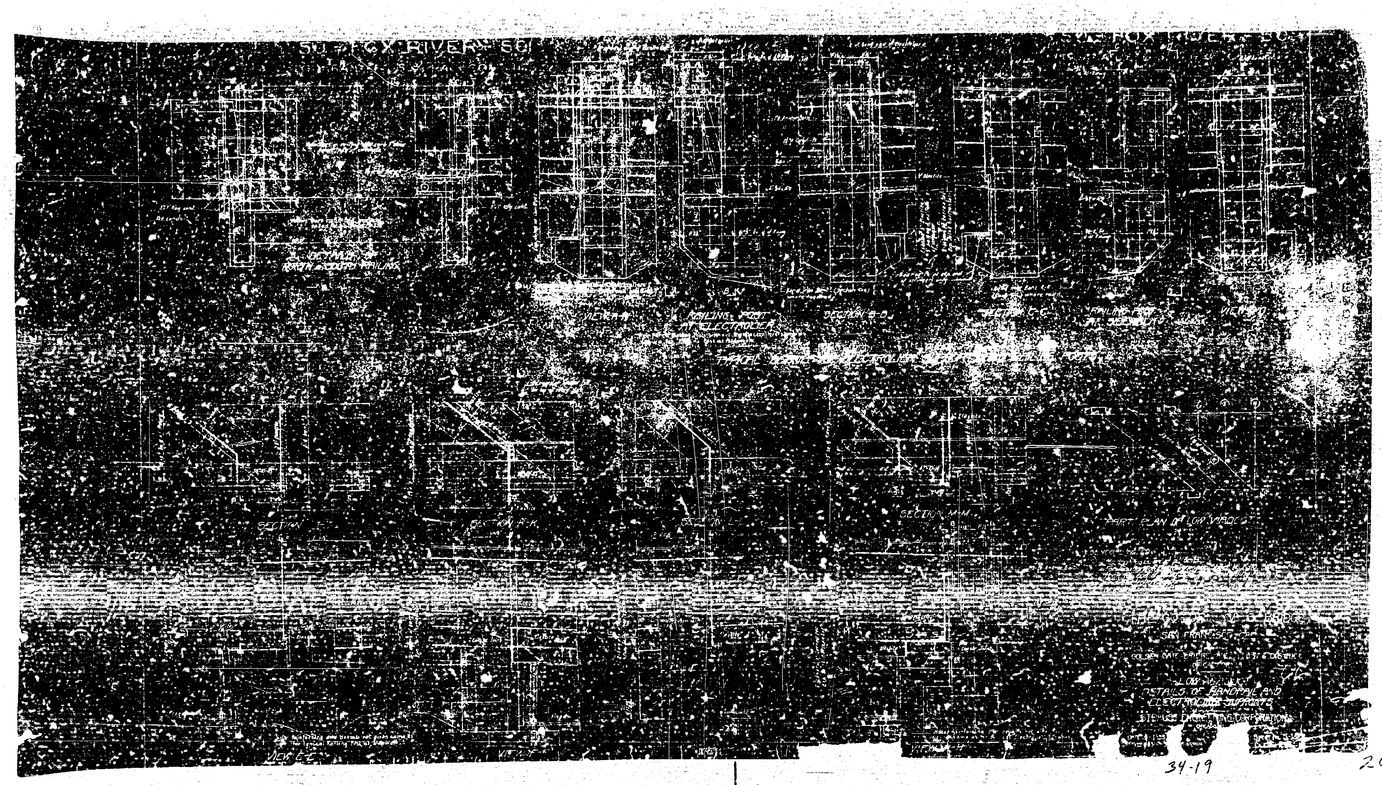

34-19

20

AS BUILT PLANS
Contract No. UNKNOWN
Date Completed
Document No. Year 8-93

24X

I HEREBY CERTIFY THAT THIS IS A TRUE AND ACCURATE COPY OF THE ABOVE DOCUMENT AS AN UNDER MY DIRECTION AND CONTROL ON THIS DATE IN SACRAMENTO, CALIFORNIA PURSUANT TO AUTHORIZATION BY THE DIRECTOR OF TRANSPORTATION.

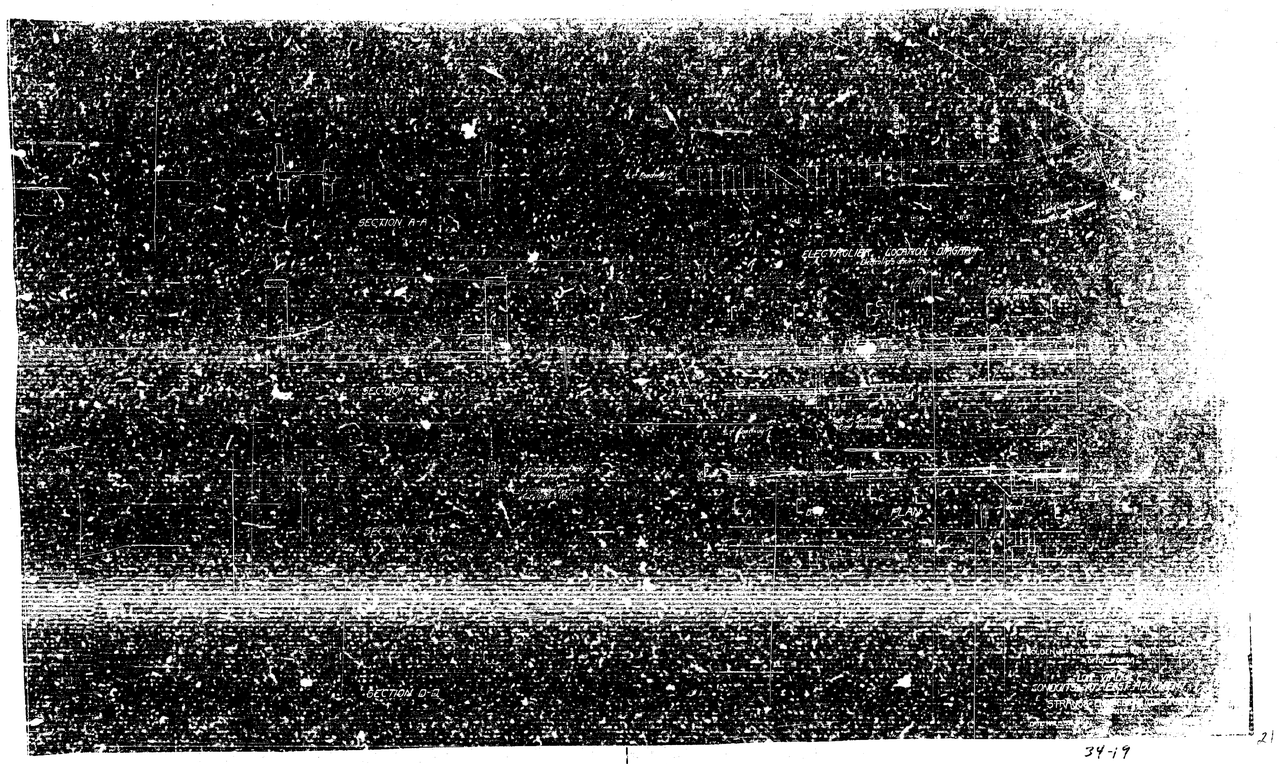

21

34-19

AS BUILT PLANS
Contract No. UNKNOWN
Date Completed
Document No. Hono R7 25

24X

THEREBY CERTIFY THAT THIS IS A TRUE AND ACCURATE COPY OF THE ABOVE DOCUMENT TAKEN UNDER MY DIRECTION AND CONTROL ON THIS DATE IN ACCORDANCE WITH THE PROPER PURPOSE TO AUTHORIZATION BY THE DIRECTOR OF TRANSPORTATION.

 

34-19

22

AS BUILT PLANS
Contract No.
Date Completed
Document No.

24X

 

34-19

23

AS BUILT PLANS
Contract No. [illegible]
Date Completed
Document No. [illegible]

24X

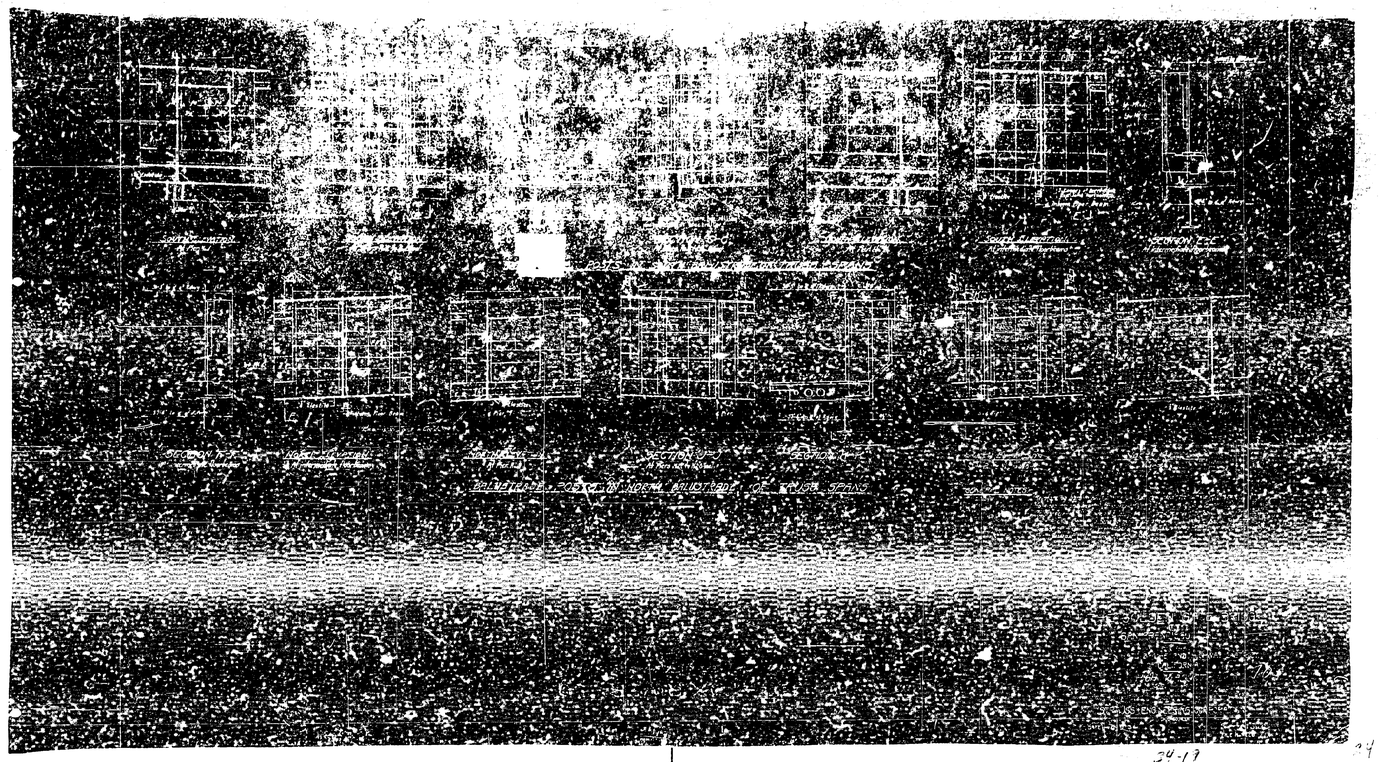

24-19

24

AS BUILT PLANS
Contract No. [illegible]
Date Completed
Document No. [illegible]

24X

[illegible]

34-19 25

AS BUILT PLANS
Contract No. UNKNOWN
Date Completed
Document No. 4000 8593

24X

I HEREBY CERTIFY THAT THIS IS A TRUE AND ACCURATE COPY OF THE ABOVE DOCUMENT TAKEN UNDER MY DIRECTION AND CONTROL ON THIS DATE IN SACRAMENTO, CALIFORNIA PURSUANT TO AUTHORIZATION BY THE DIRECTOR OF TRANSPORTATION.

DATE	SIGNATURE	TITLE
7/5/78	Joseph M. Costa	Supervisor of Microfilm

DAS-53-78

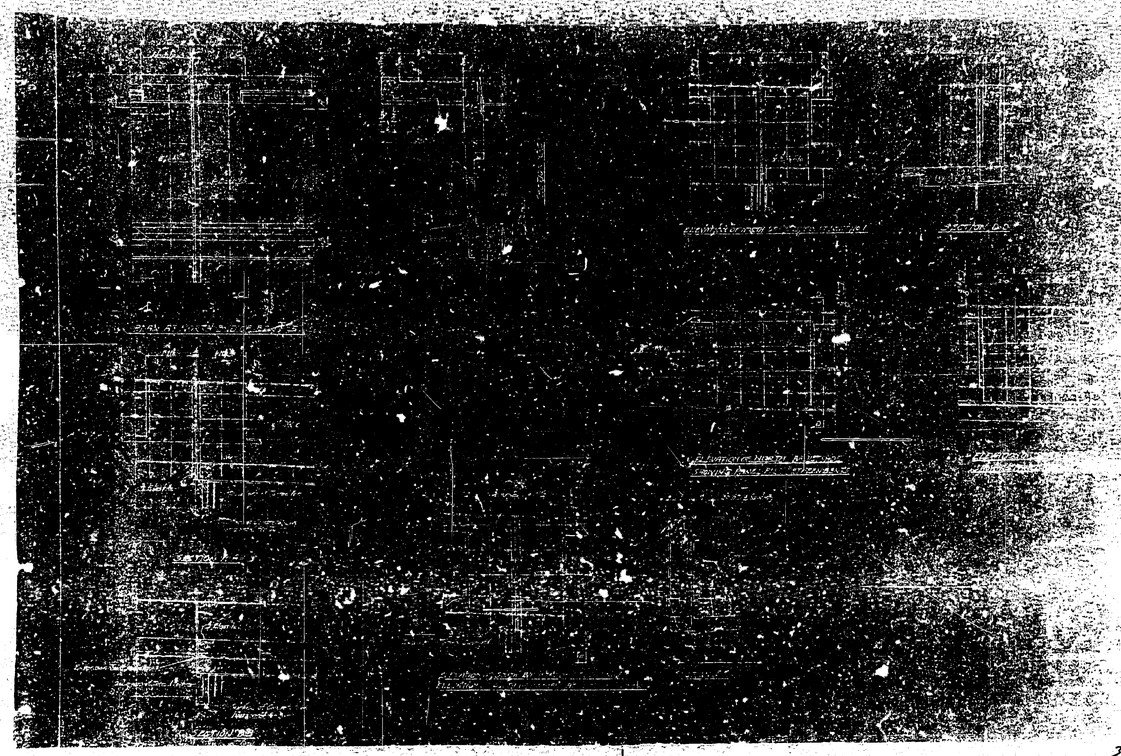

76

34-19

AS BUILT PLANS
Contract No. UNKNOWN
Date Completed
Document No. 4000 8593

24X

I HEREBY CERTIFY THAT THIS IS A TRUE AND ACCURATE COPY OF THE ABOVE DOCUMENT TAKEN UNDER MY DIRECTION AND CONTROL ON THIS DATE IN SACRAMENTO, CALIFORNIA PURSUANT TO AUTHORIZATION BY THE DIRECTOR OF TRANSPORTATION.

DATE	SIGNATURE	TITLE
7/5/95	Joseph M. Costa	Supervisor of Microfilm

DAS-93-78

27

34-19

AS BUILT PLANS
Contract No. UNKNOWN
Date Completed
Document No. 4000 8593

24X

I HEREBY CERTIFY THAT THIS IS A TRUE AND ACCURATE COPY OF THE ABOVE DOCUMENT TAKEN UNDER MY DIRECTION AND CONTROL ON THIS DATE IN SACRAMENTO, CALIFORNIA PURSUANT TO AUTHORIZATION BY THE DIRECTOR OF TRANSPORTATION.

DATE	SIGNATURE	TITLE
1/5/78	Joseph M. Costa	Supervisor of Microfilm

DAS-1/5/78

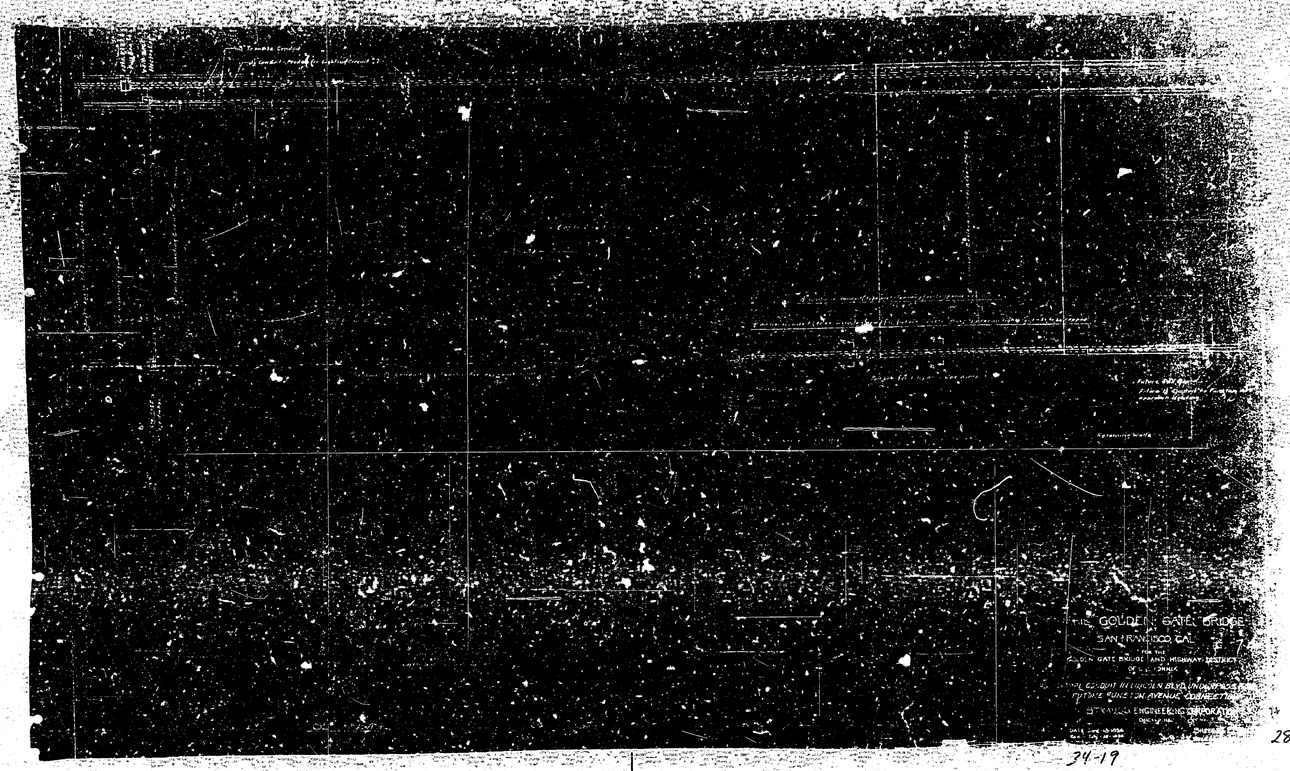

28

34-19

AS BUILT PLANS
Contract No. UNKNOWN
Date Completed
Document No. 4000 8593

24X

I HEREBY CERTIFY THAT THIS IS A TRUE AND ACCURATE COPY OF THE ABOVE DOCUMENT TAKEN UNDER MY DIRECTION AND CONTROL ON THIS DATE IN SACRAMENTO, CALIFORNIA PURSUANT TO AUTHORIZATION BY THE DIRECTOR OF TRANSPORTATION.

DATE	SIGNATURE	TITLE
11/5/78	Joseph M Coutas	Supervisor of Microfilm

DAS-55-75

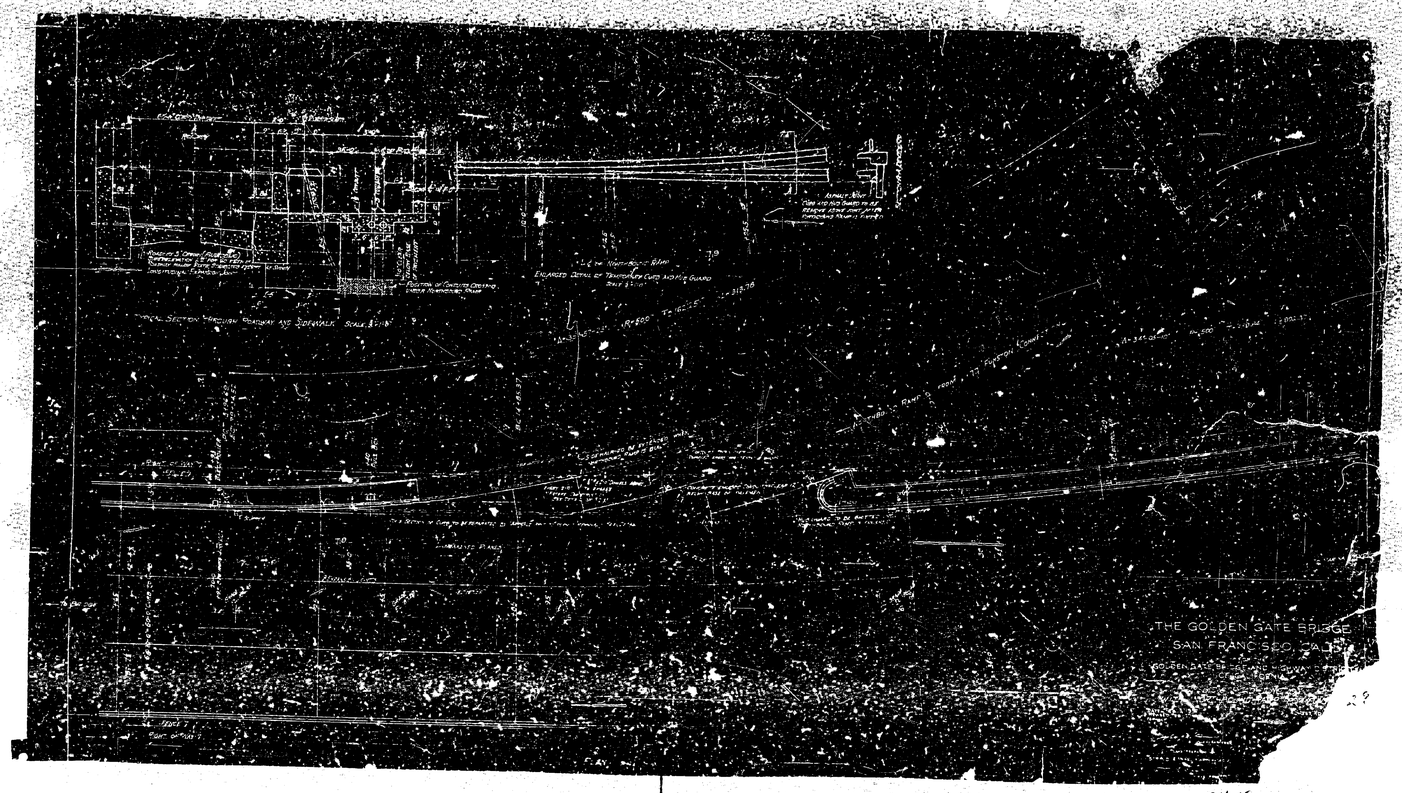

34-19

AS BUILT PLANS
Contract No. UNKNOWN
Date Completed
Document No. 40028593

24X

I HEREBY CERTIFY THAT THIS IS A TRUE AND ACCURATE COPY OF THE ABOVE DOCUMENT TAKEN UNDER MY DIRECTION AND CONTROL ON THIS DATE IN SACRAMENTO, CALIFORNIA PURSUANT TO AUTHORIZATION BY THE DIRECTOR OF TRANSPORTATION.

DATE: 4/5/78 | SIGNATURE: Joseph M. Costa | TITLE: Supervisor of Microfilm

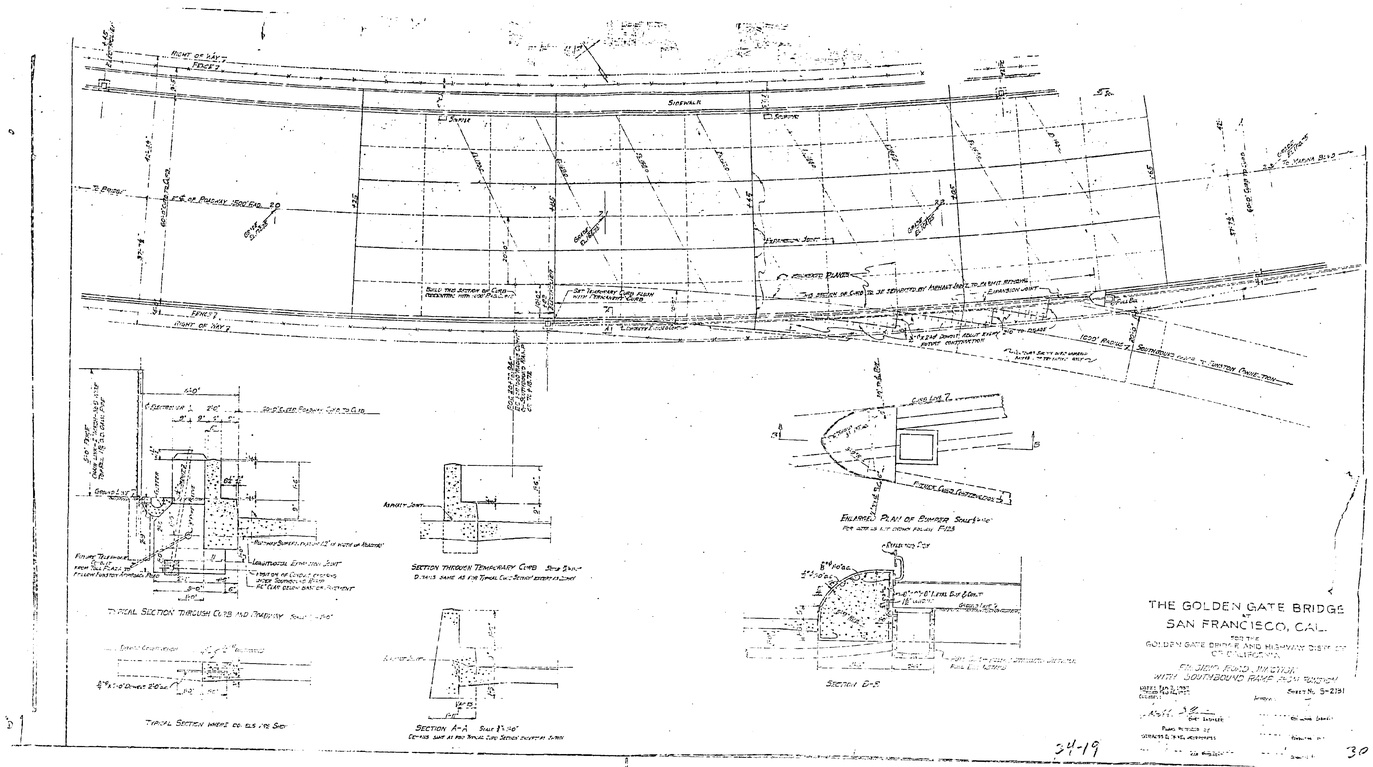

AS BUILT PLANS
Contract No. [illegible]
Date Completed
Document No. [illegible]

24X

I HEREBY CERTIFY THAT THIS IS A TRUE AND ACCURATE COPY OF THE ABOVE DOCUMENT TAKEN UNDER MY DIRECTION AND CONTROL ON THIS DATE IN SACRAMENTO, CALIFORNIA PURSUANT TO AUTHORIZATION BY THE DIRECTOR OF TRANSPORTATION.

DATE [illegible] | SIGNATURE [illegible] | TITLE [illegible]

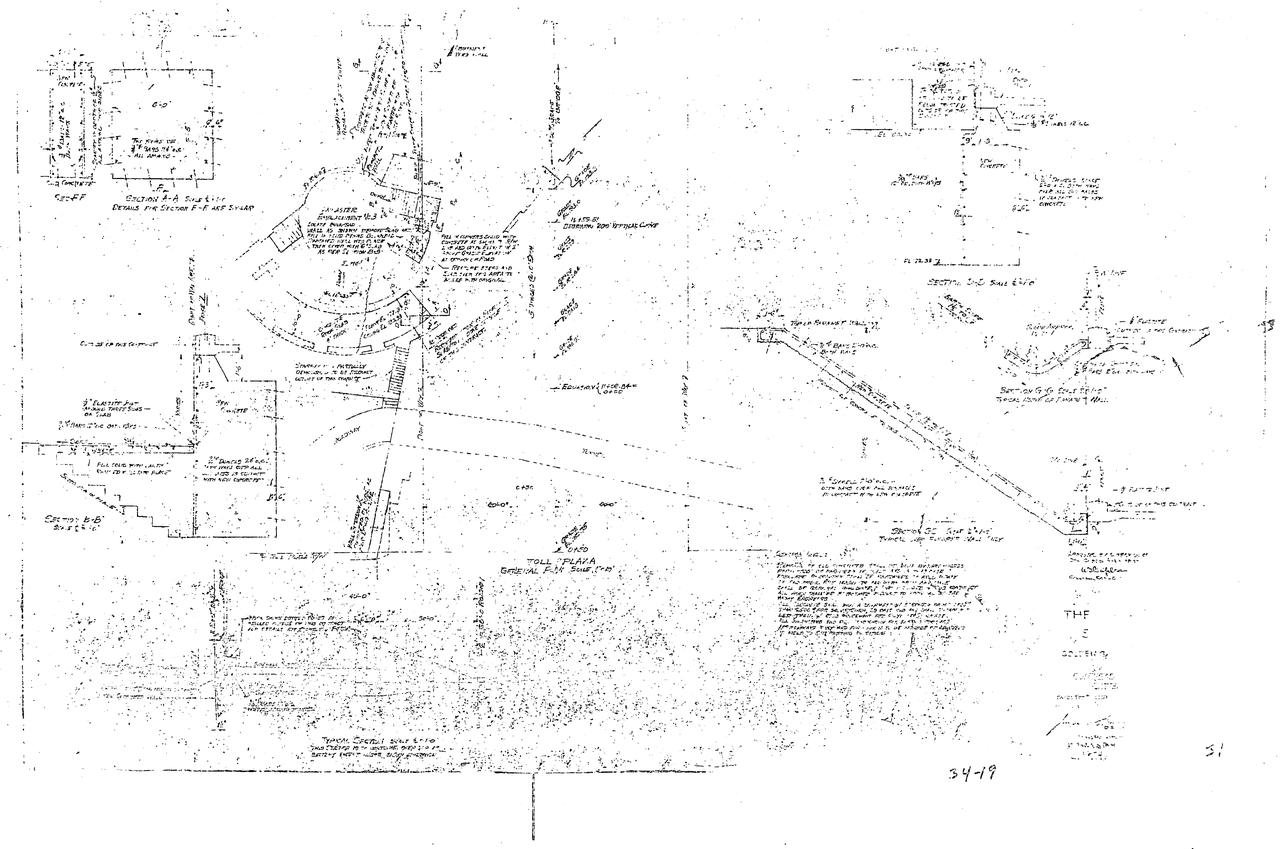

AS BUILT PLANS
Contract No.
Date Completed
Document No.

24X

I HEREBY CERTIFY THAT THIS IS A TRUE AND ACCURATE COPY OF THE ABOVE DOCUMENT TAKEN UNDER MY DIRECTION AND CONTROL ON THIS DATE IN SACRAMENTO, CALIFORNIA PURSUANT TO AUTHORIZATION BY THE DIRECTOR OF TRANSPORTATION.

DATE | SIGNATURE | TITLE